


T. 2N., R. 31E., W.M.

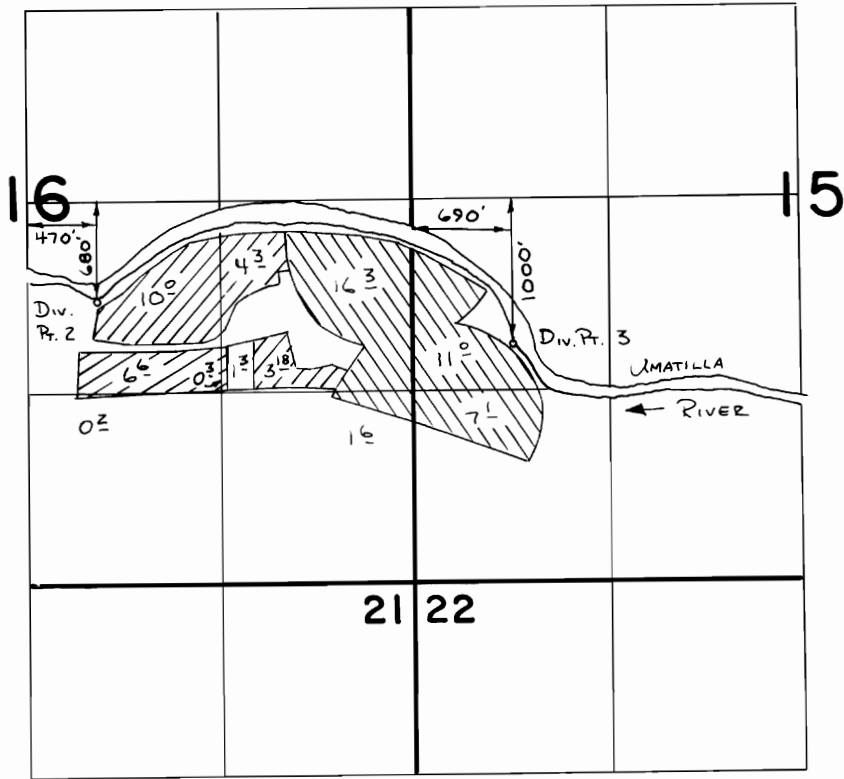

SCALE 1" = 1320'



T-5773  
Div. Pt. 3



T-5774  
Div. Pt. 2



T-5794  
Div. Pt. 2

**FINAL PROOF SURVEY**  
UNDER

**TRANSFERS 5774, 5773, 5794**  
IN NAME OF

.....LEWIS...LIVESTOCK.....INC.....

Surveyed 11-3-1988, by V.L. Church