


T. 2N., R. 31E., W.M.

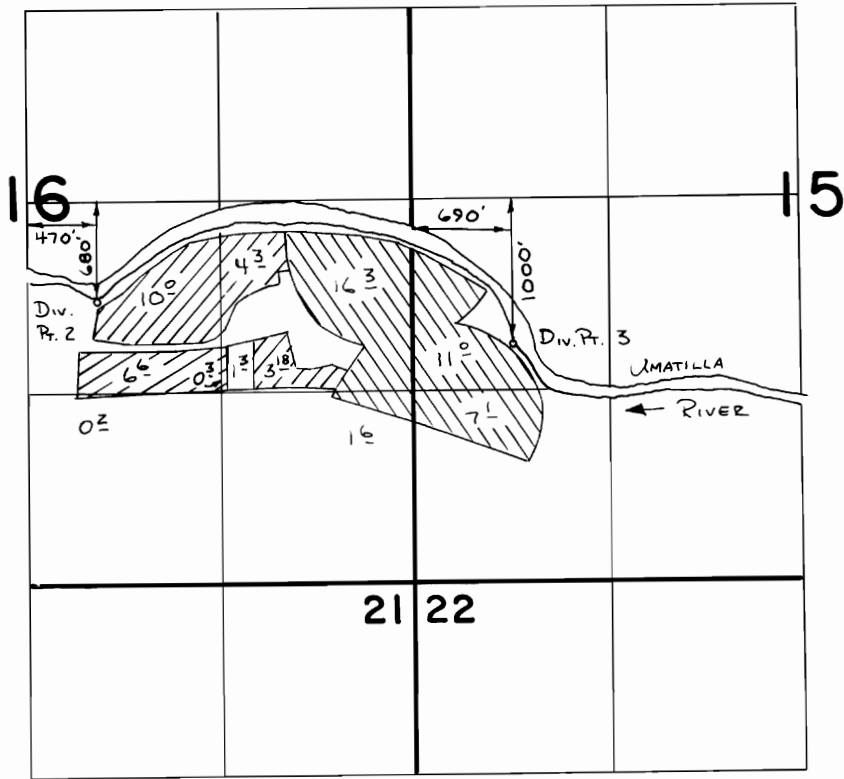

SCALE 1" = 1320'



T-5773
Div. Pt. 3



T-5774
Div. Pt. 2



T-5794
Div. Pt. 2

FINAL PROOF SURVEY
UNDER

TRANSFERS 5774, 5773, 5794
IN NAME OF

.....LEWIS...LIVESTOCK.....INC.....

Surveyed 11-3-1988, by V.L. Church