


T. 2N., R. 32E., W.M.

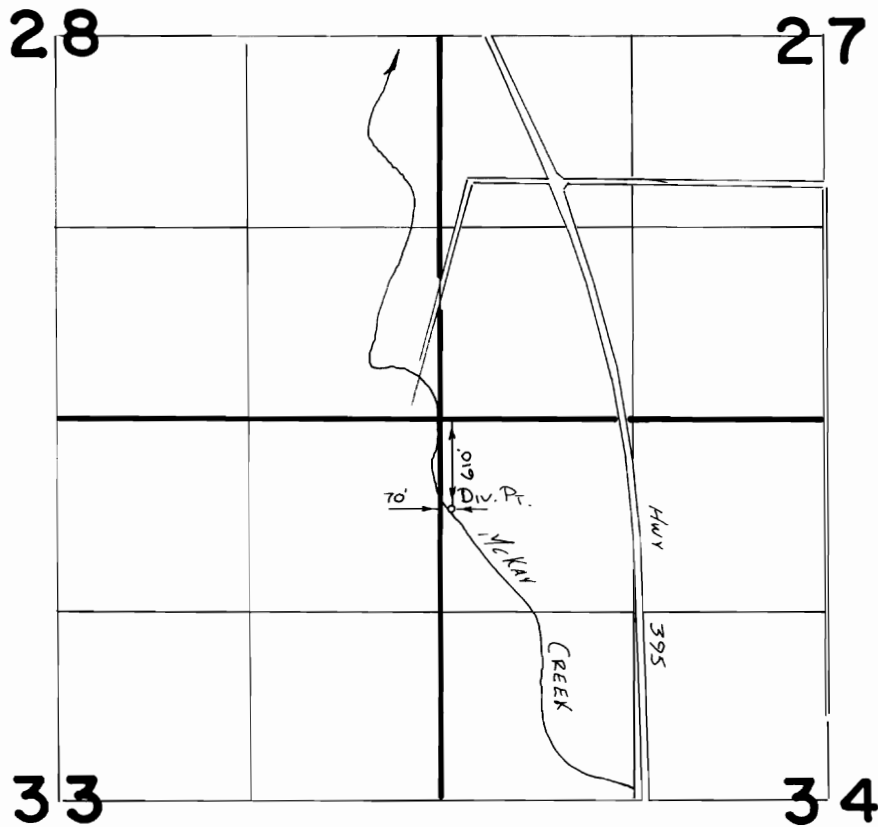

SCALE 1" = 1320'

FINAL PROOF SURVEY
UNDER

TRANSFER 5778
IN NAME OF

DANIEL R. & CAROLE N. WICKLANDER

Surveyed 6-25-1987, by V. Church