

T17S R12E Sec 17

Transfer
5789

#2

See Map 17 12 17A

SCALE 1:4800




RECEIVED

AUG 14 1986

WATER RESOURCES DEPT
SALEM, OREGON

See Map 17 12 17C

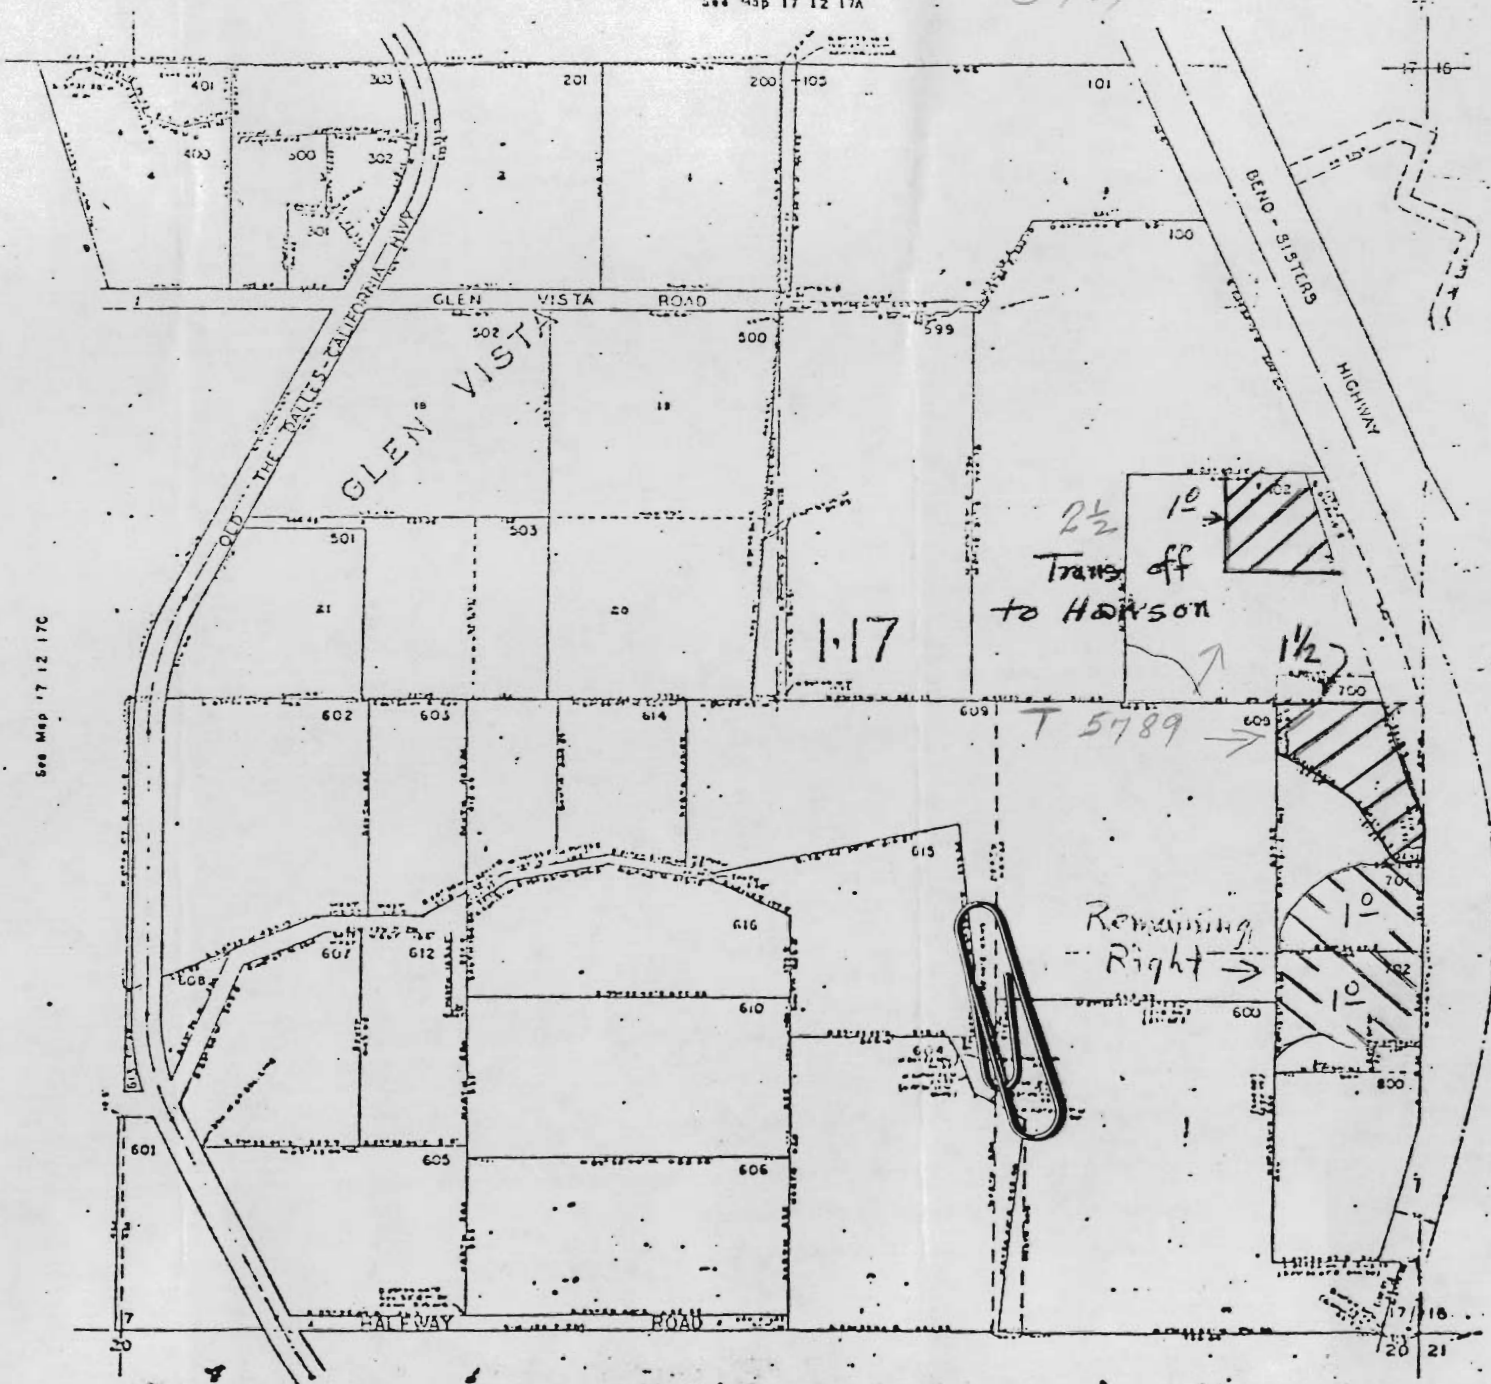

See Map 17 12 16C



T-5655
T-5789

T.17S, R.12E

"OFF" map for
Transfer 5655

Note: Acreage figures
indicated on this off
map do not represent
the actual mapped area
shown. Since the decree
does not match the map
in either of these two
40's, these are based on
adjustments made by
DRIC and that have been
a part of their records.

RECEIVED

JUL 21 1986

WATER RESOURCES DEPT
SALEM, OREGON