


T. 38S., R. 4W., W.M.

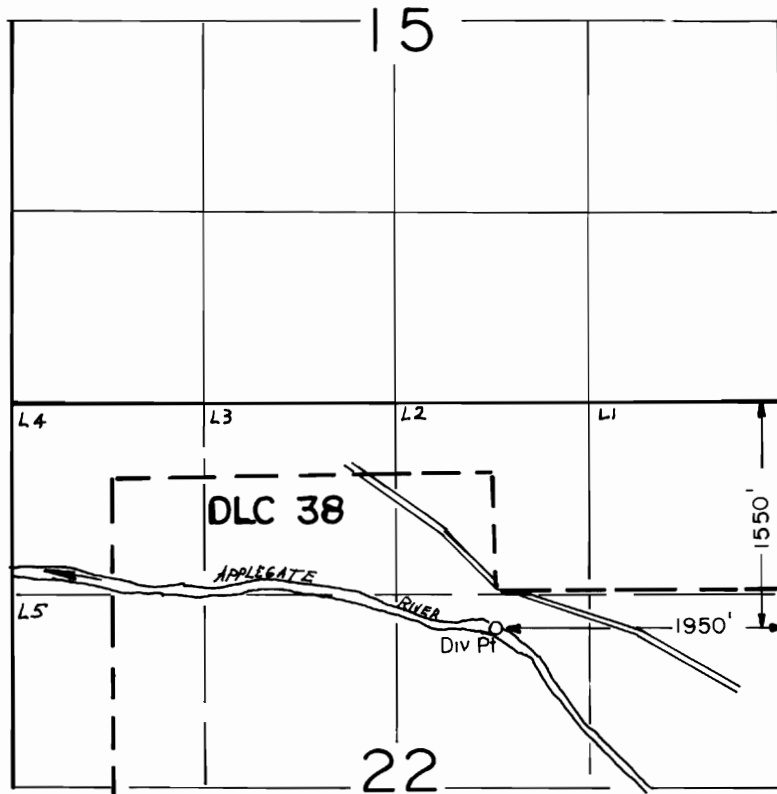

SCALE: 1" = 1320'

FINAL PROOF SURVEY

UNDER

TRANSFER NO. 5793

Application No. Permit No.

IN NAME OF

..... **HERRIOTT BROTHERS RANCH**

Surveyed NOV. 22, 1989., by B.S. JAMES