


T. 1N., R. 32E., W.M.

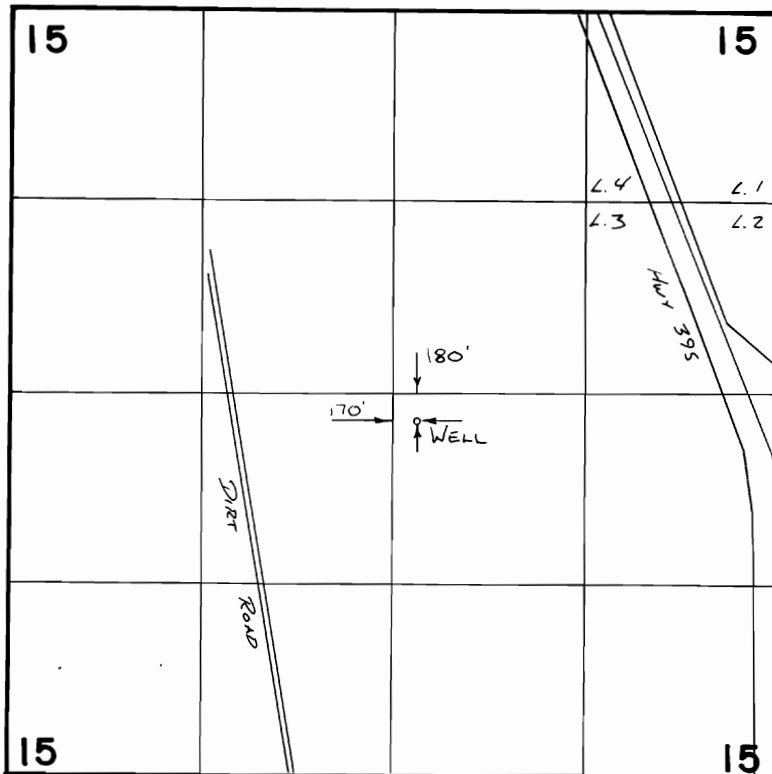

SCALE 1" = 1320'

FINAL PROOF SURVEY
UNDER

TRANSFER 5796
IN NAME OF

PENDLETON...COUNTRY...CLUB,....INC.....

Surveyed 11-4..... 1988, by V.L. Church.....