


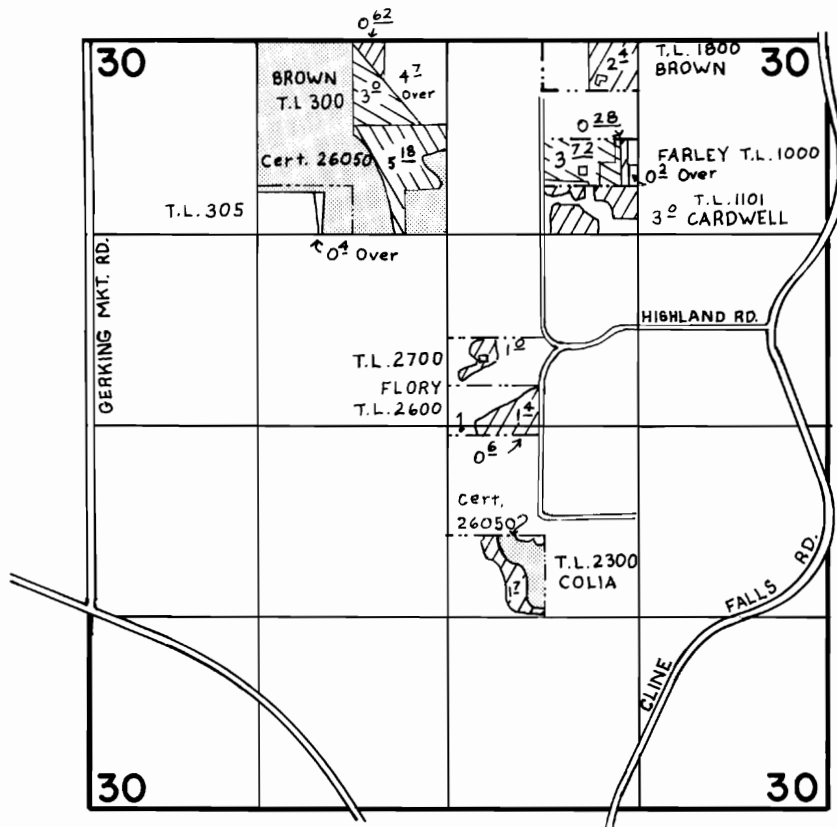

T.16S.,R.12E.,W.M.




SCALE: 1" = 1320'

FINAL PROOF SURVEY

UNDER

TRANSFERS 4143 , 4857 

AND PART OF 4964  (2/2)

IN NAME OF

CARDWELL et. al.

Surveyed APRIL 17, 1986., by LESLIE OLSON.....

T.I.D.
V. 35/P. 579
V. 31/P. 670
V. 35/P. 232