


T. 39 S., R. 19 E., W.M.

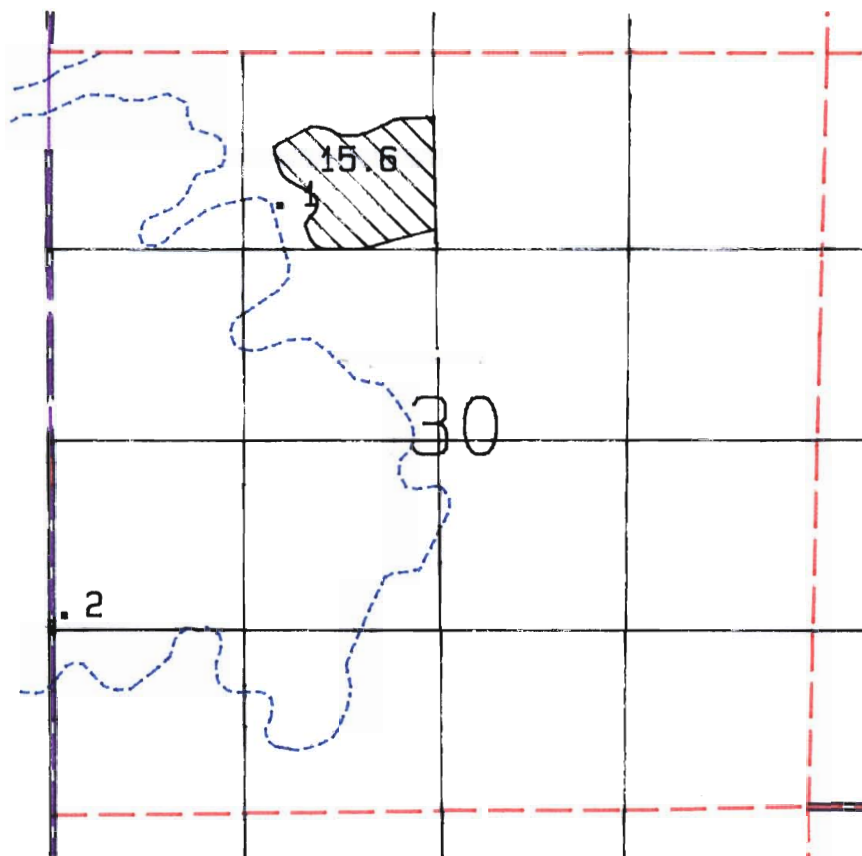

SCALE: 1 = 1320

FINAL PROOF SURVEY
UNDER

TRANSFER 5822

IN NAME OF

Nicholas Rago / LAKEVIEW WATER USERS

Surveyed Oct. 20, 1987 By T.M. Warren