
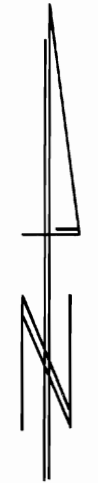


T3S, R1E, WM

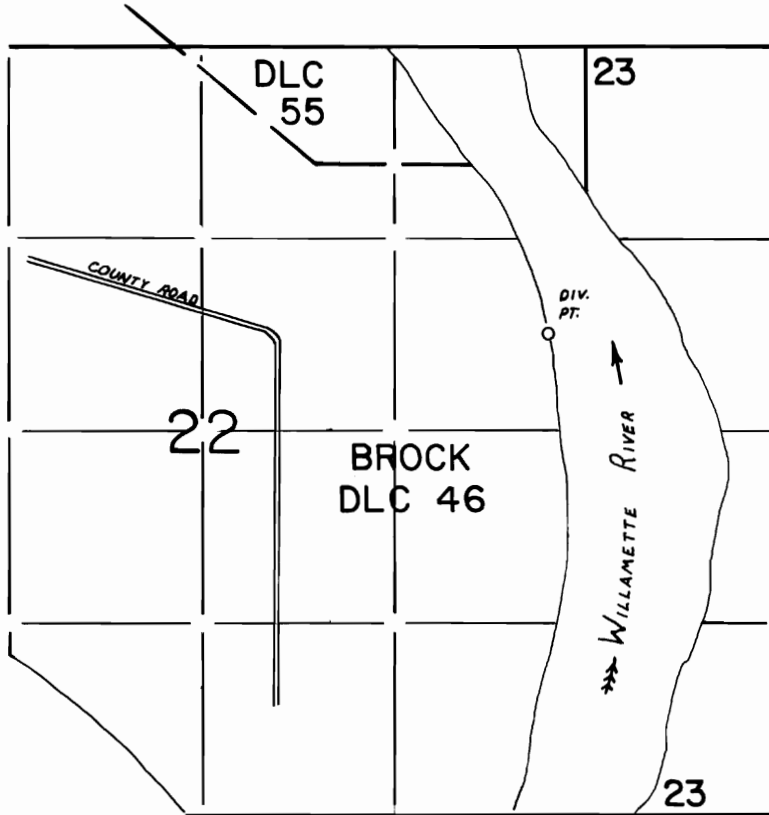

SCALE
1" = 1320'

DIV. PT. LOCATED: 3340 FT N & 2325 E FROM S 1/4
CORNER SECTION 22

FINAL PROOF SURVEY UNDER

Transfer No.5823.....

Application No. Permit No.

IN NAME OF

GARNET PANKEY

Surveyed JULY...22... 1987., by T.M. WARREN....