


# T. 39 S., R. 3 W., W. M.

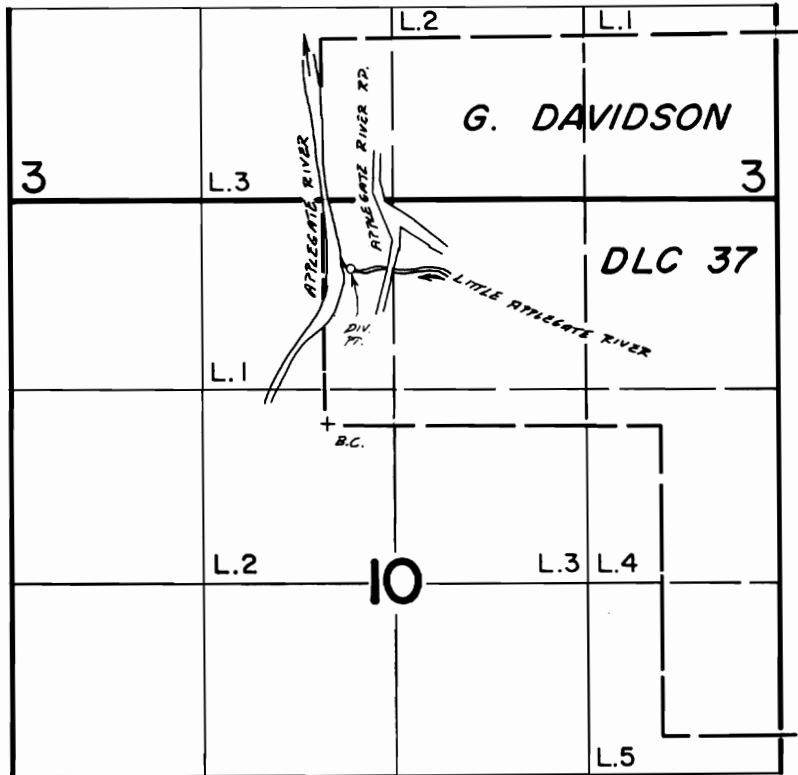

DIV. PT.: 450' S & 300' W from N  $\frac{1}{4}$  COR. SEC. 10.

Scale 1"=1320'

## FINAL PROOF SURVEY

UNDER

Transfer No. 5832

Application No. .... Permit No. ....

IN NAME OF

**BEN C. & MARTELLE B. GERWICK Jr,**

Surveyed Jan. 12, 1988, by B.S. JAMES.....