


T. 2&3N., R. 30E., W.M.

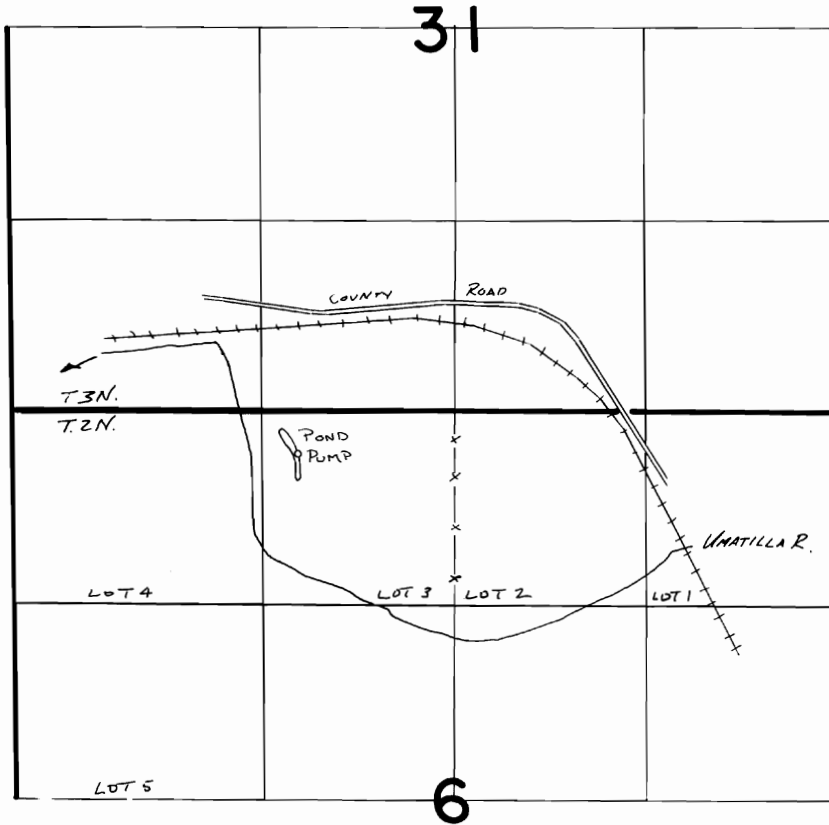

SCALE 1" = 1320'

WELL LOC: 290'S. & 1080'W. FROM N¼ COR SEC 6

**FINAL PROOF SURVEY**  
UNDER

**TRANSFER 5847**  
IN NAME OF

.....**BETTY FULLETON**.....

Surveyed 8.5..... 1987., by V.A. Church.....