


25857

EAST

SEE MAP 36 5 17AC

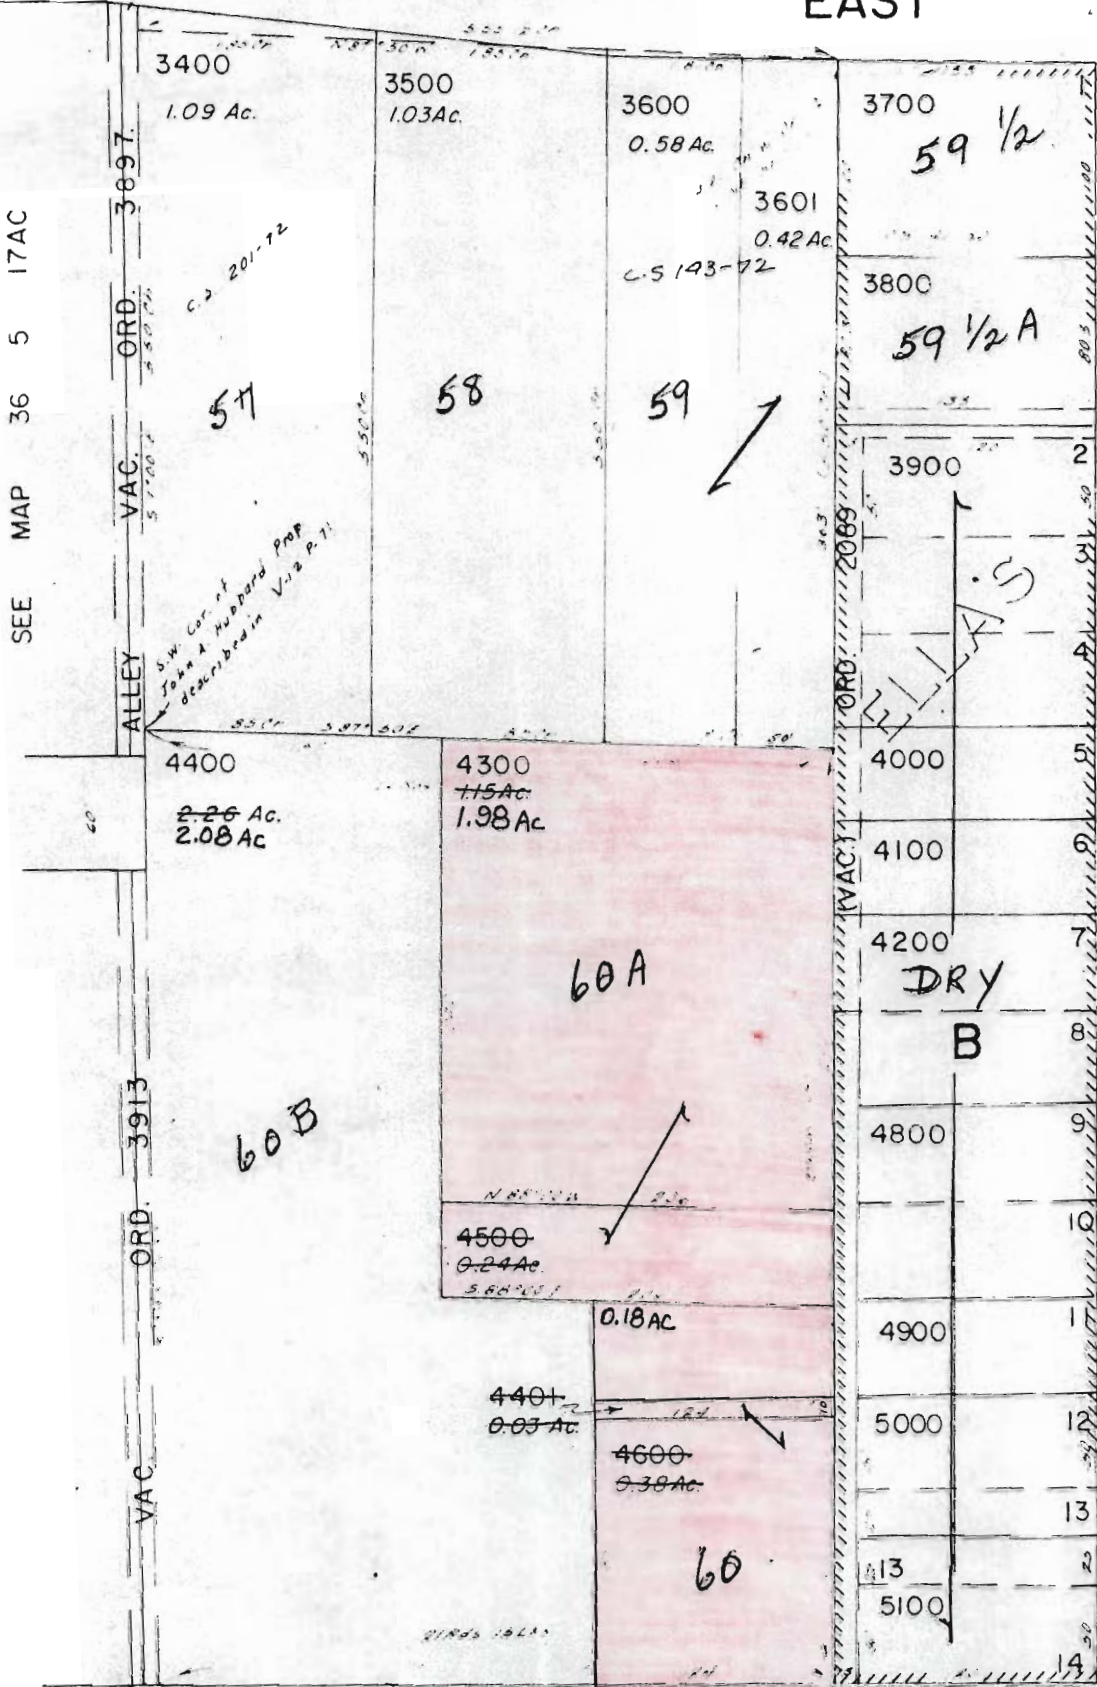

STREET

IITH

EAST RECEIVED

SEP - 9 1986

WATER RESOURCES DEPT SEE MAP SALEM, OREGON

36-5-17-14


1"=100'

T-5850

RECEIVED

SEP - 9 1986

WATER RESOURCES DEPT
SALEM, OREGON

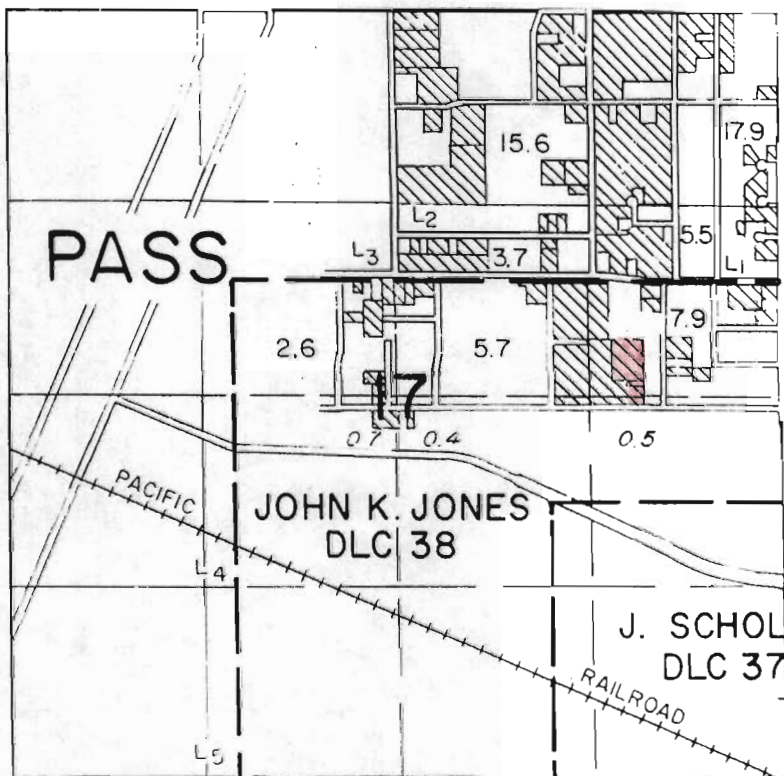

36-5-17


REDWOOD

RECEIVED


SEP 3 1966

UNION AVENUE

WATER RESOURCES
SALEM, OREGON

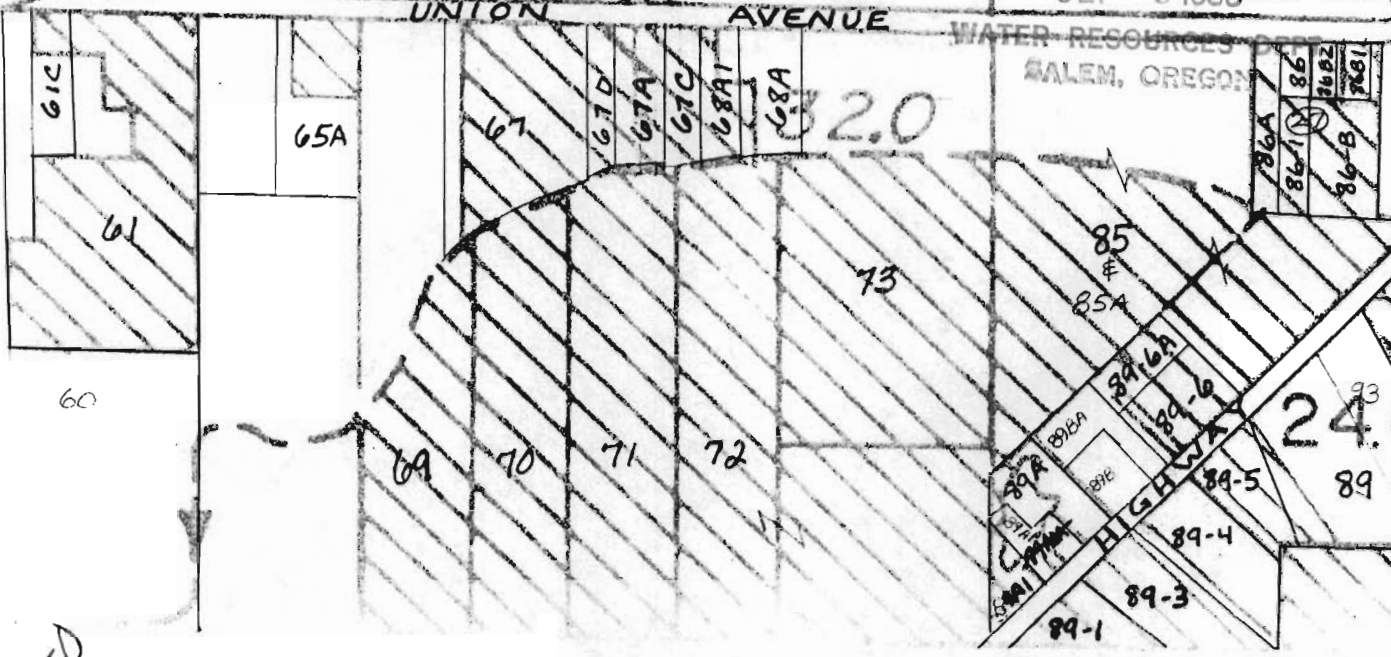

T-5850

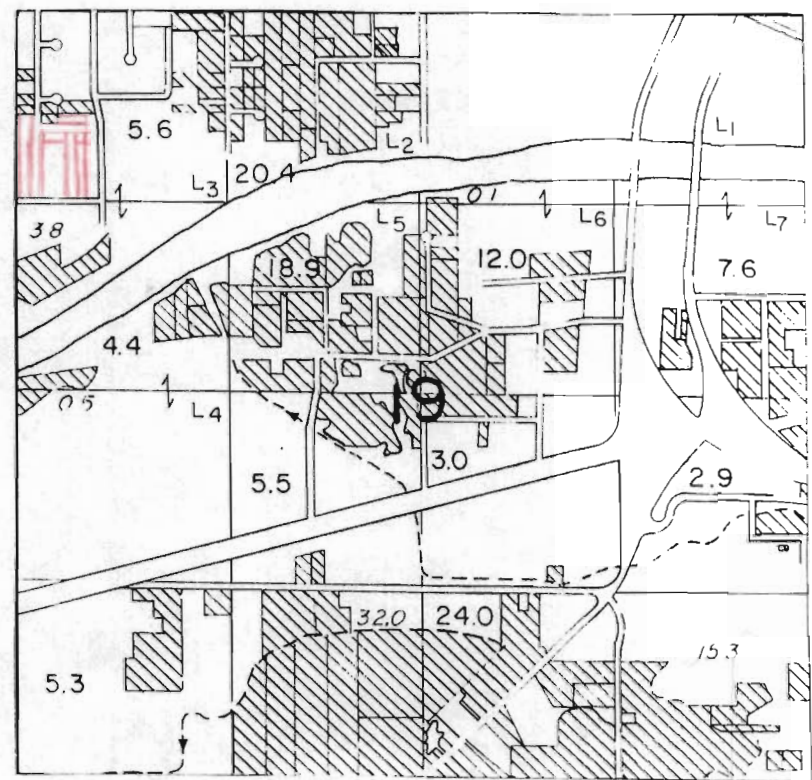

36-5-19

36-5-17

T-5850


RECEIVED

SEP - 9 1986

WATER RESOURCES DEPT
SALEM, OREGON

TIED TO
36-5-08DD, TL 3407

36-5-17
1982

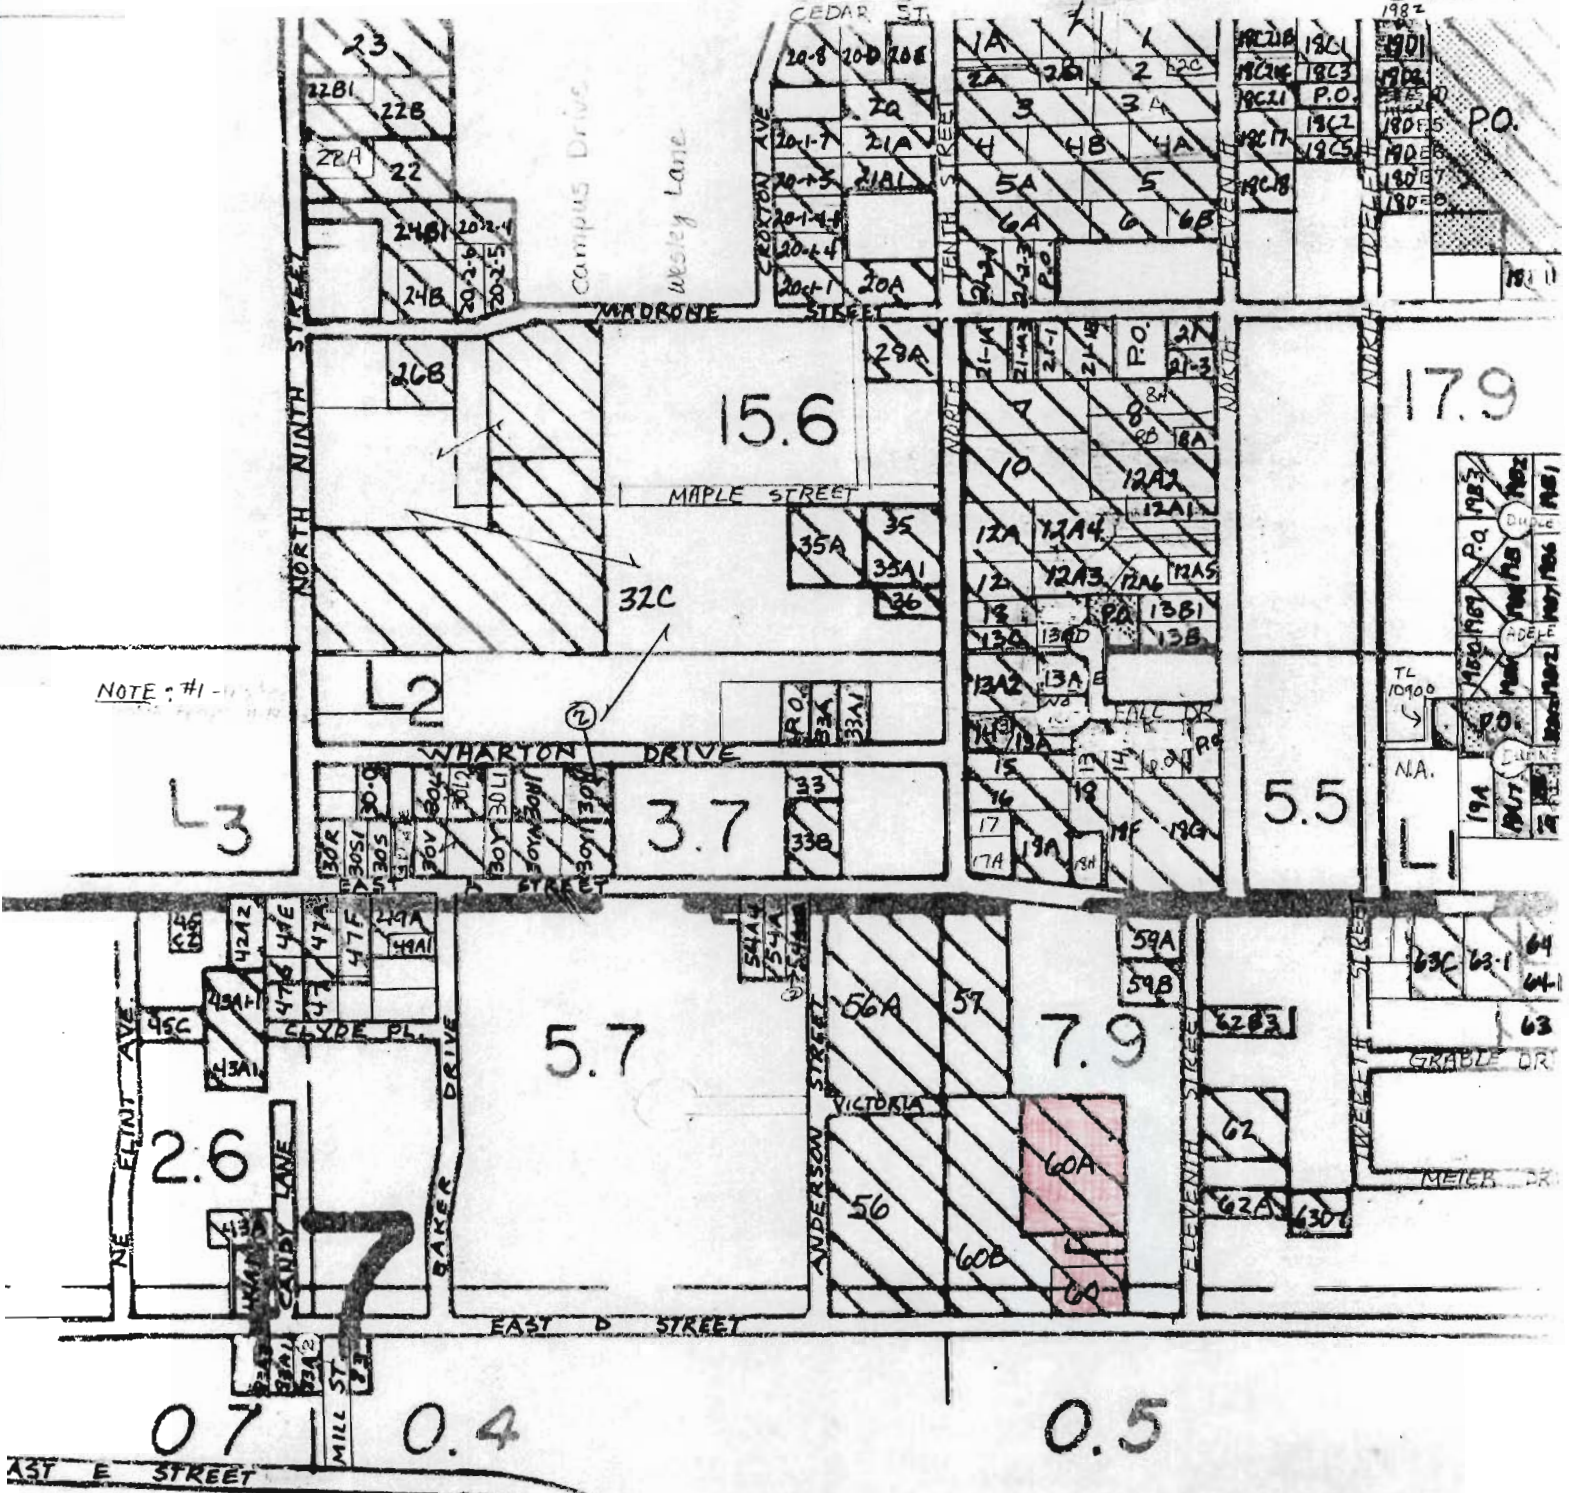

HN K. JONES


36-5-19

T-5850

RECEIVED



SEP - 9 1986

WATER RESOURCES DEPT
SALEM, OREGON

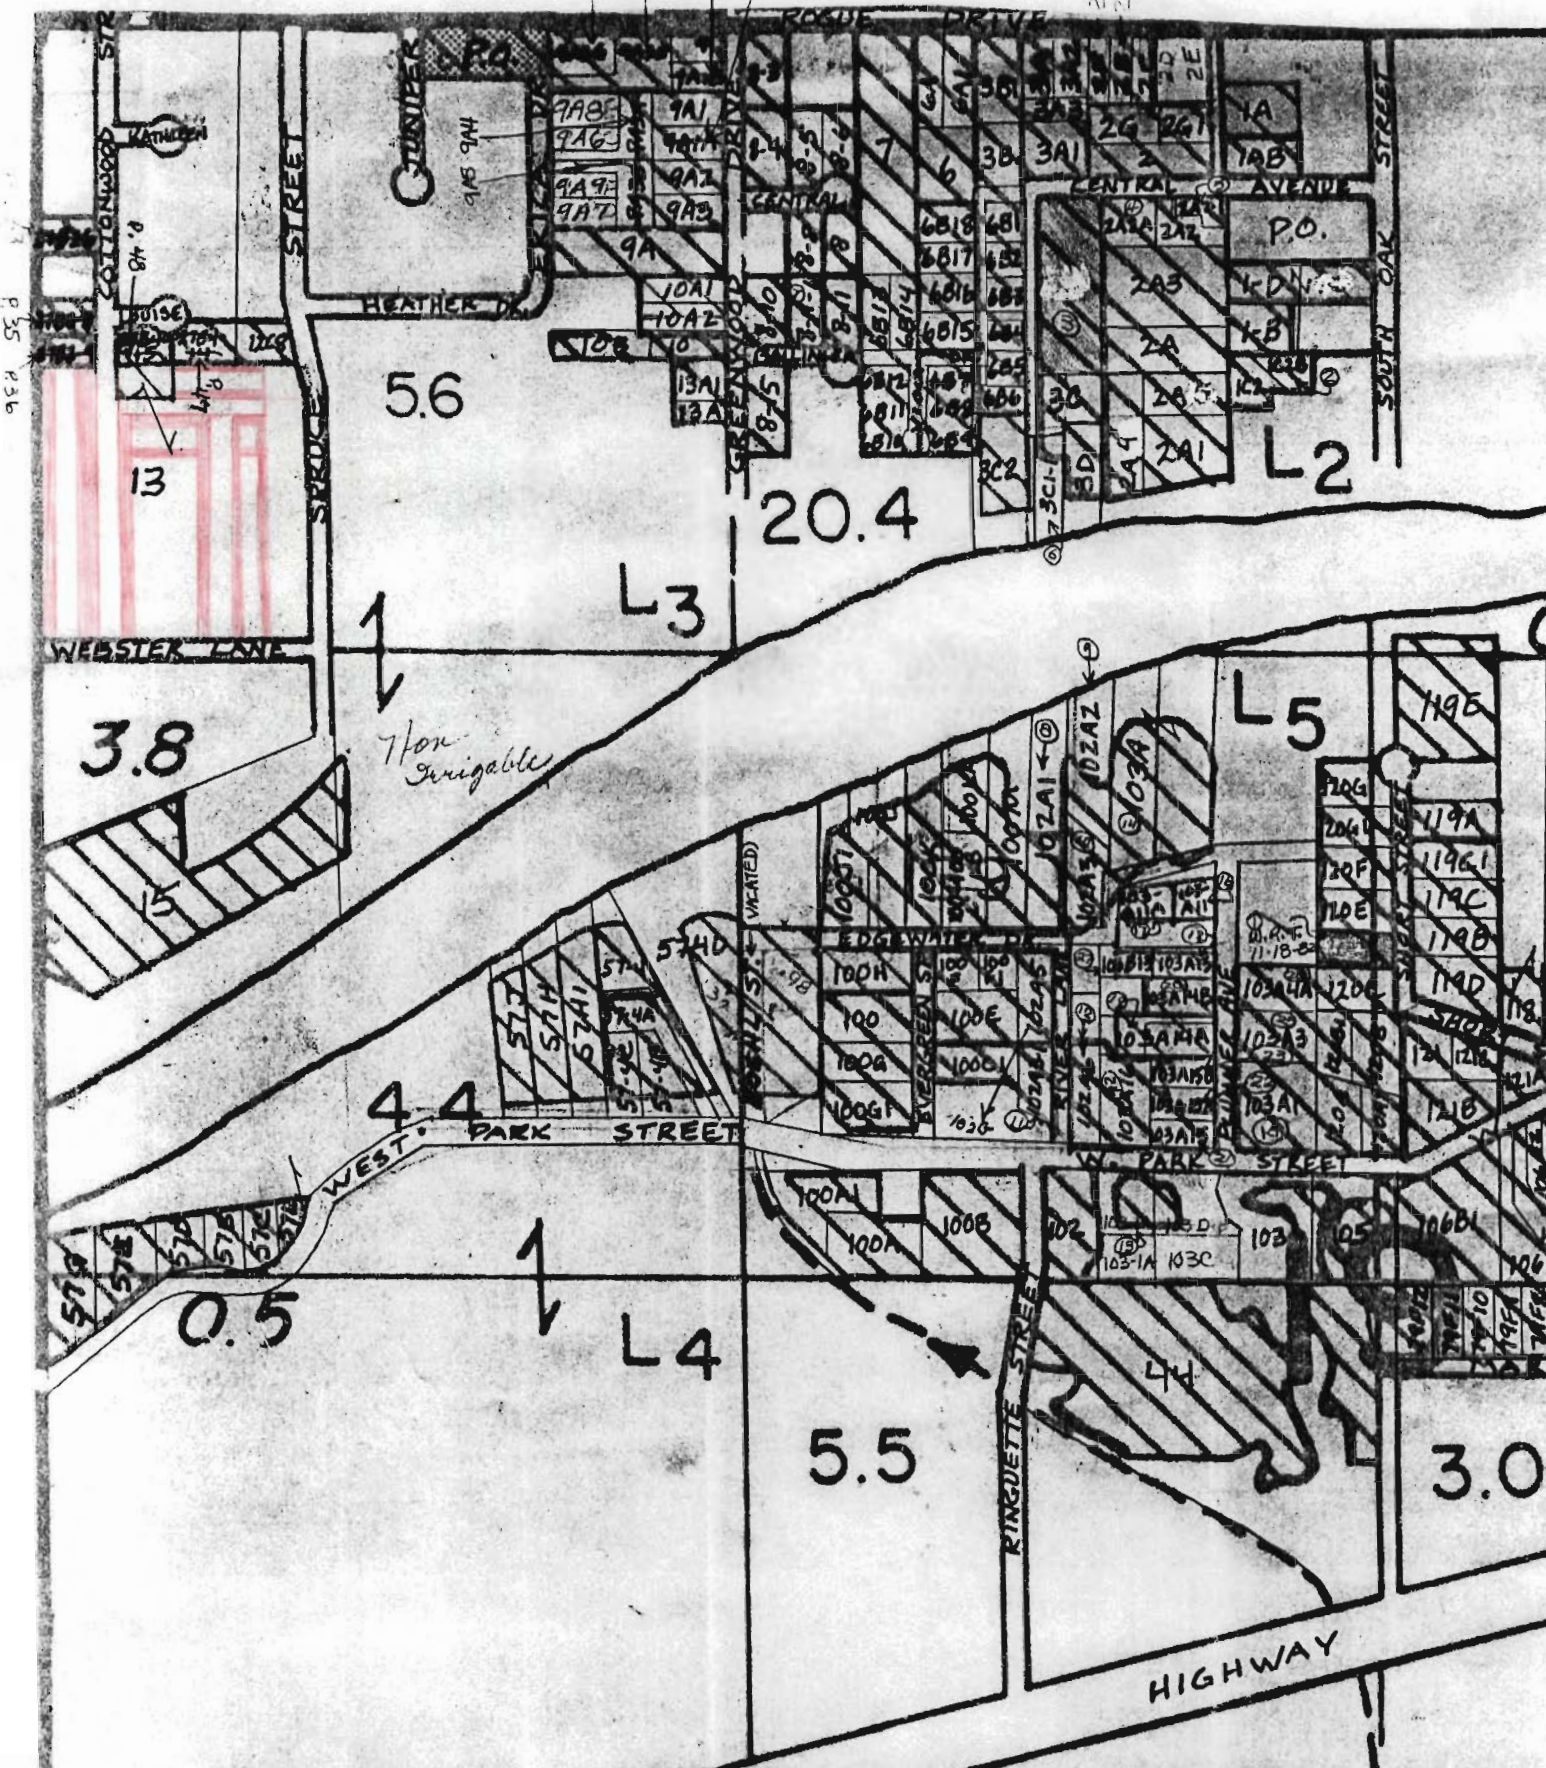

SEE MAP 36 6 24A

T-5850

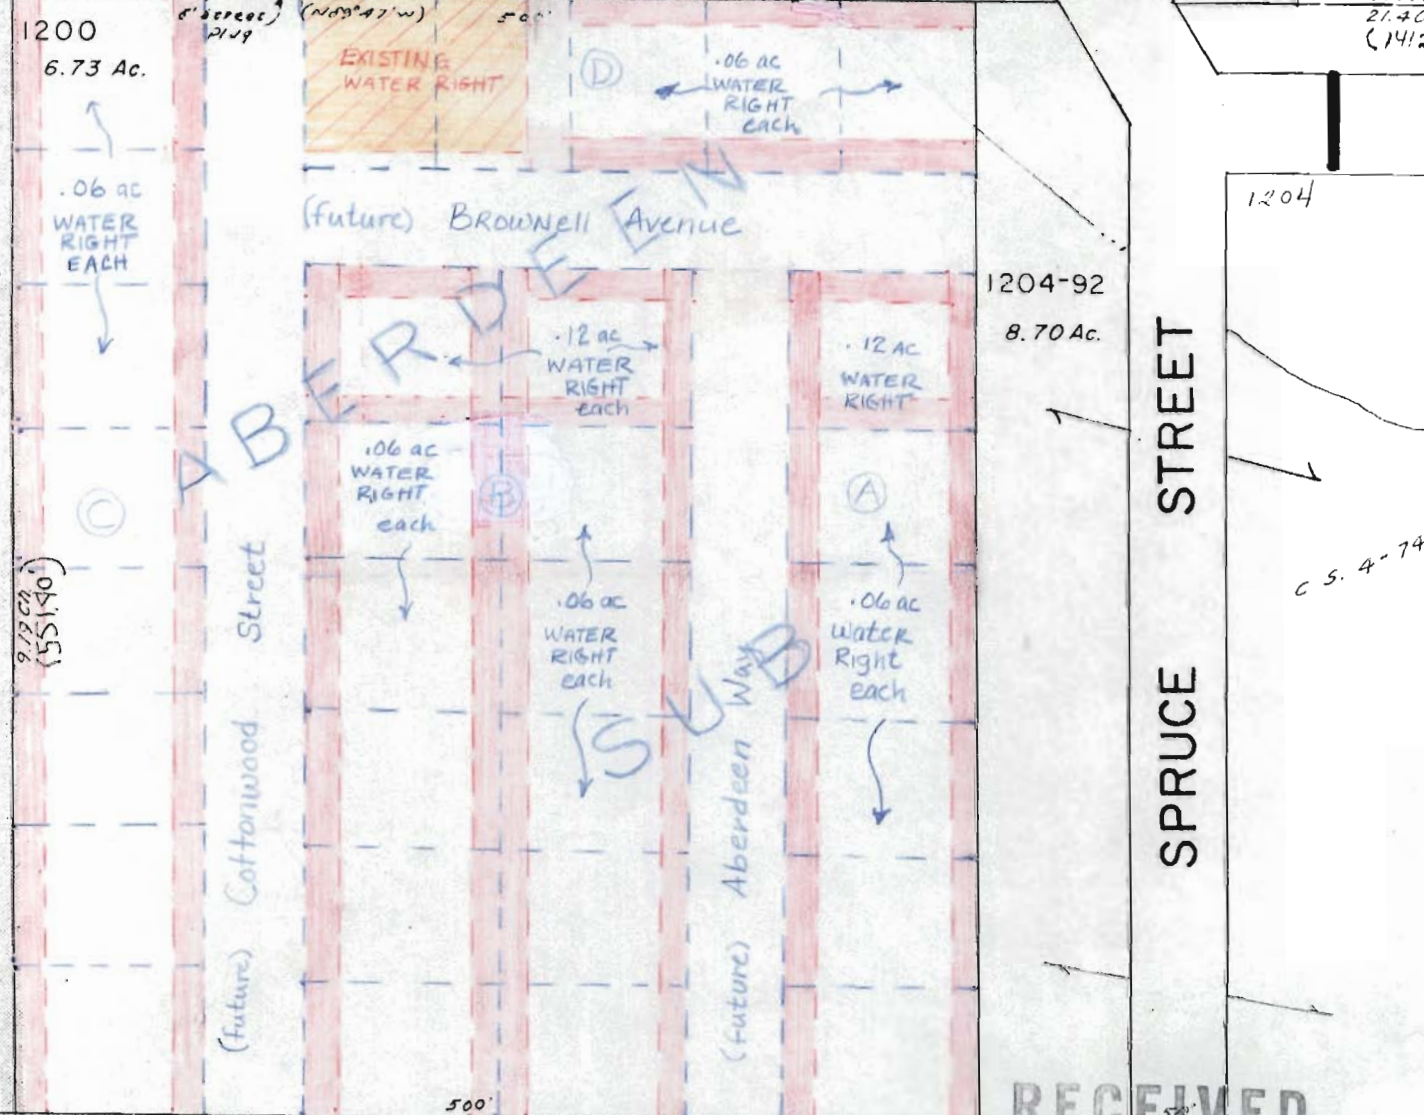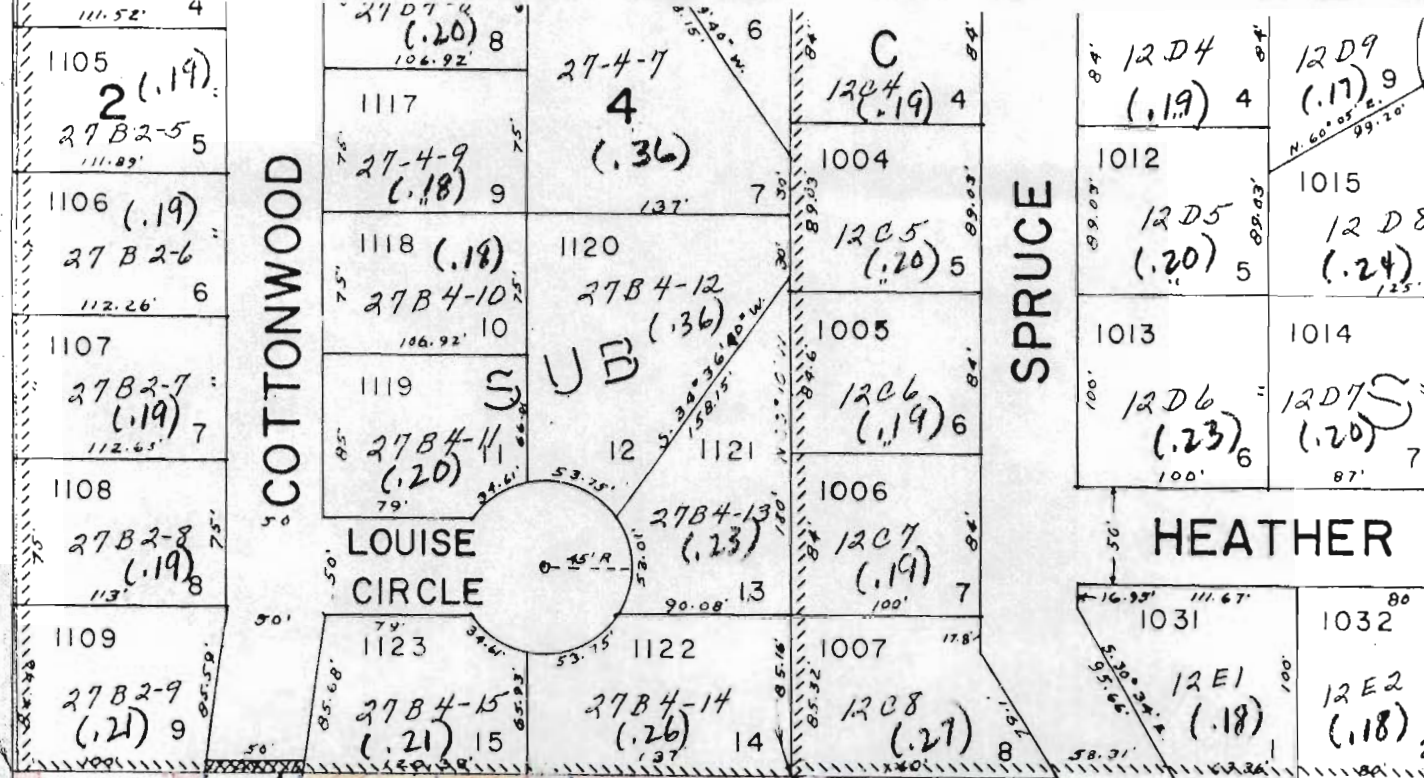

RECEIVED

SEP - 9 1986

36-5-19-22

1" = 100'

WATER RESOURCES DEPT SALEM, OREGON