


T. 34 & 35 S., R. 1 W., W. M.

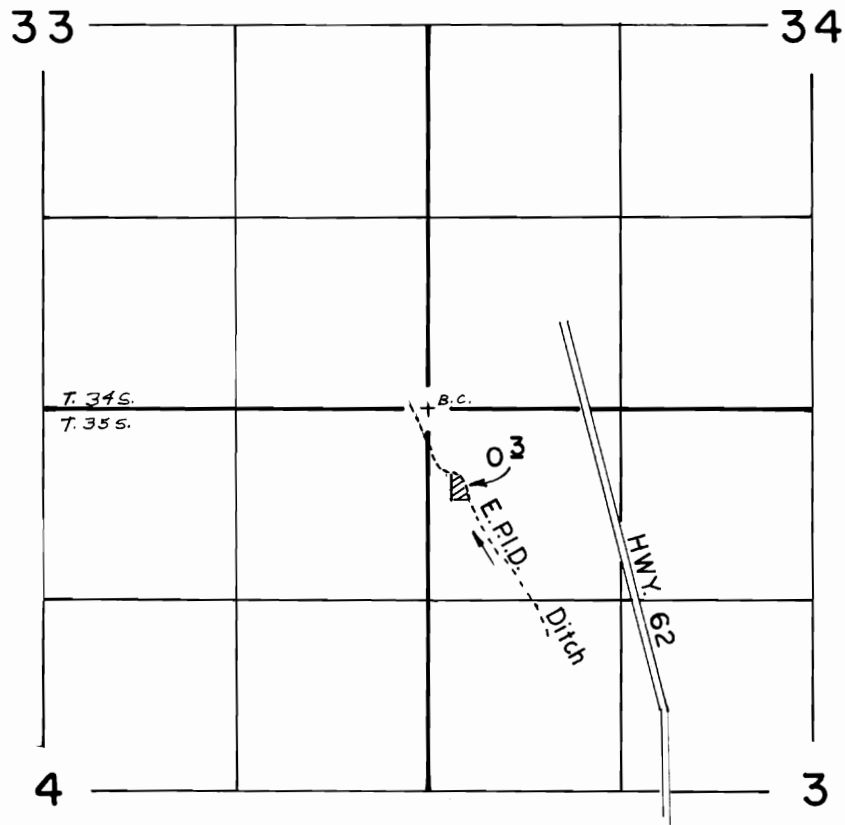

E. P. I. D. Diversion No. 1: NE 1/4 NE 1/4 Sec. 10,
 T. 35 S., R. 2 E., W. M.;
 1130' S. & 700' W. from
 NE Corner of Sec. 10

FINAL PROOF SURVEY UNDER

TRANSFER NO. 5853

Application No. Permit No.
 IN NAME OF

EAGLE.....POINT.....IRRIGATION.....DISTRICT

Surveyed APR. 2.... 1990., by B....S....JAMES....