


T.3S., R.40E., W.M.

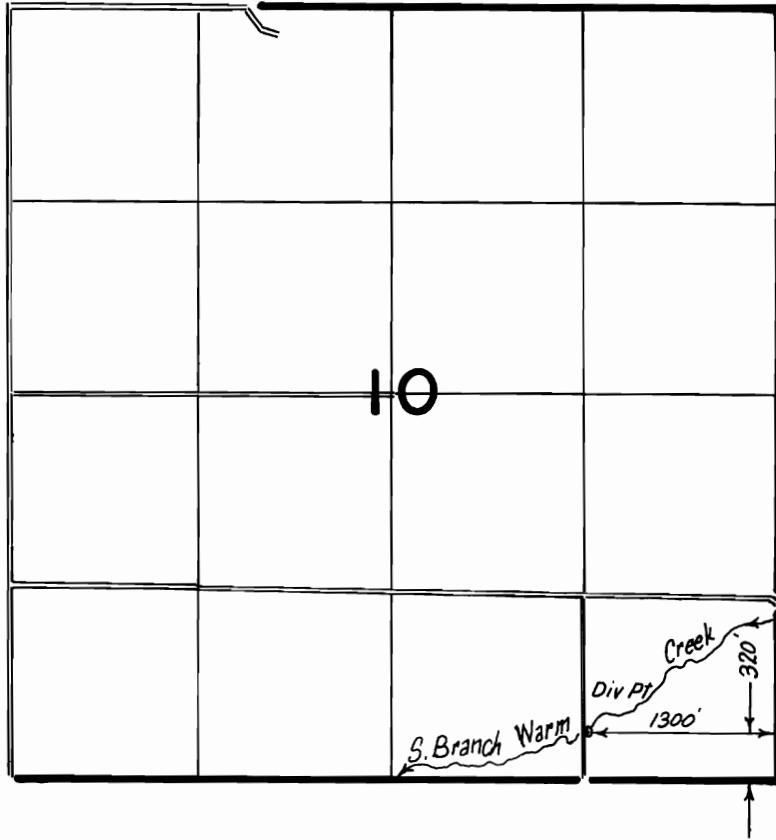

Scale: 1" = 1320'

FINAL PROOF SURVEY UNDER

TRANSFER 5856

IN NAME OF

.....KENNETH KNOTT.....

Surveyed ..7-21..... 19.87., by *Vern Church*.....