

EXHIBIT B

T-5861

T38S,R1E W.M.
T39S,R1E W.M.

PRESENT POINT
OF DIVERSION

EXISTING LOCATION
OF WATER RIGHT

RECEIVED

OCT - 9 1986


WATER RESOURCES DEPT.
SALEM, OREGON



WATER SOURCE -
ASHLAND CREEK

PROPOSED POINT
OF DIVERSION

REEDER RESERVOIR

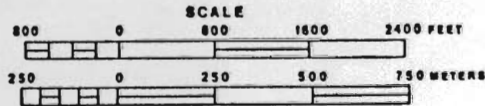

- LEGEND
- INTERSTATE NUMBERED ROUTE
 - U.S. NUMBERED ROUTE
 - STATE NUMBERED ROUTE
 - TERMINATION OF FA SYSTEM
 - DIVIDED HIGHWAY
 - STREET OPEN FOR TRAVEL
 - POST OFFICE
 - SCHOOL
 - COURT HOUSE
 - CITY HALL
 - LIBRARY
 - ARMORY
 - PUBLIC BUILDING