



RECEIVED

DEC 12 1986

WATER RESOURCES DEPT.
SALEM, OREGON

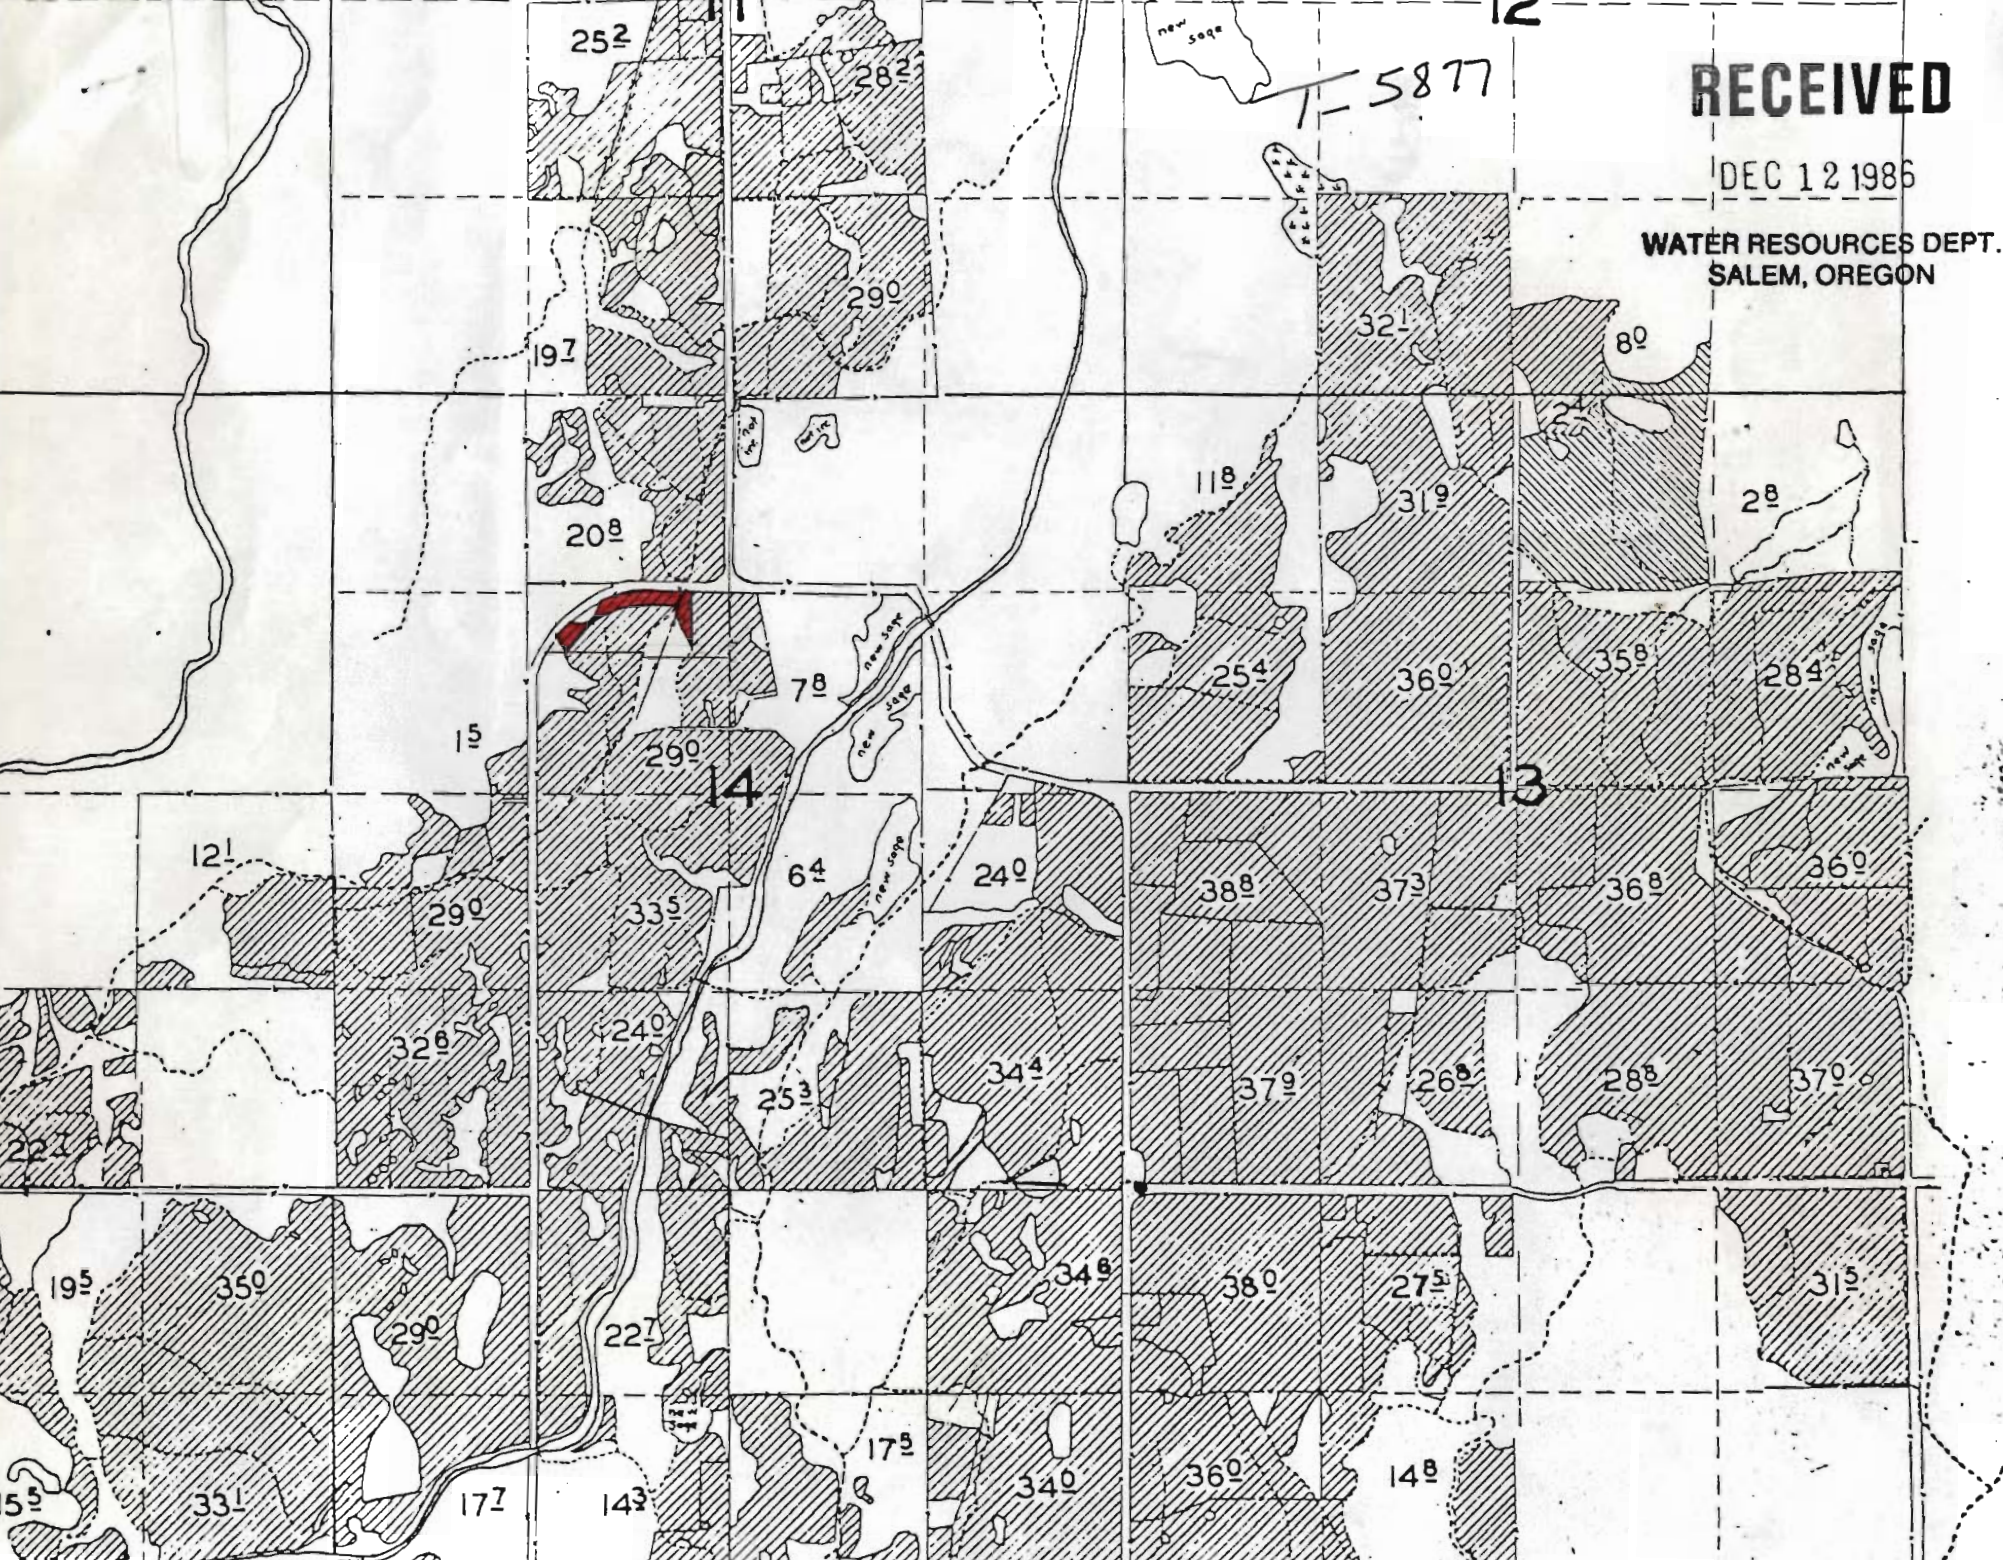

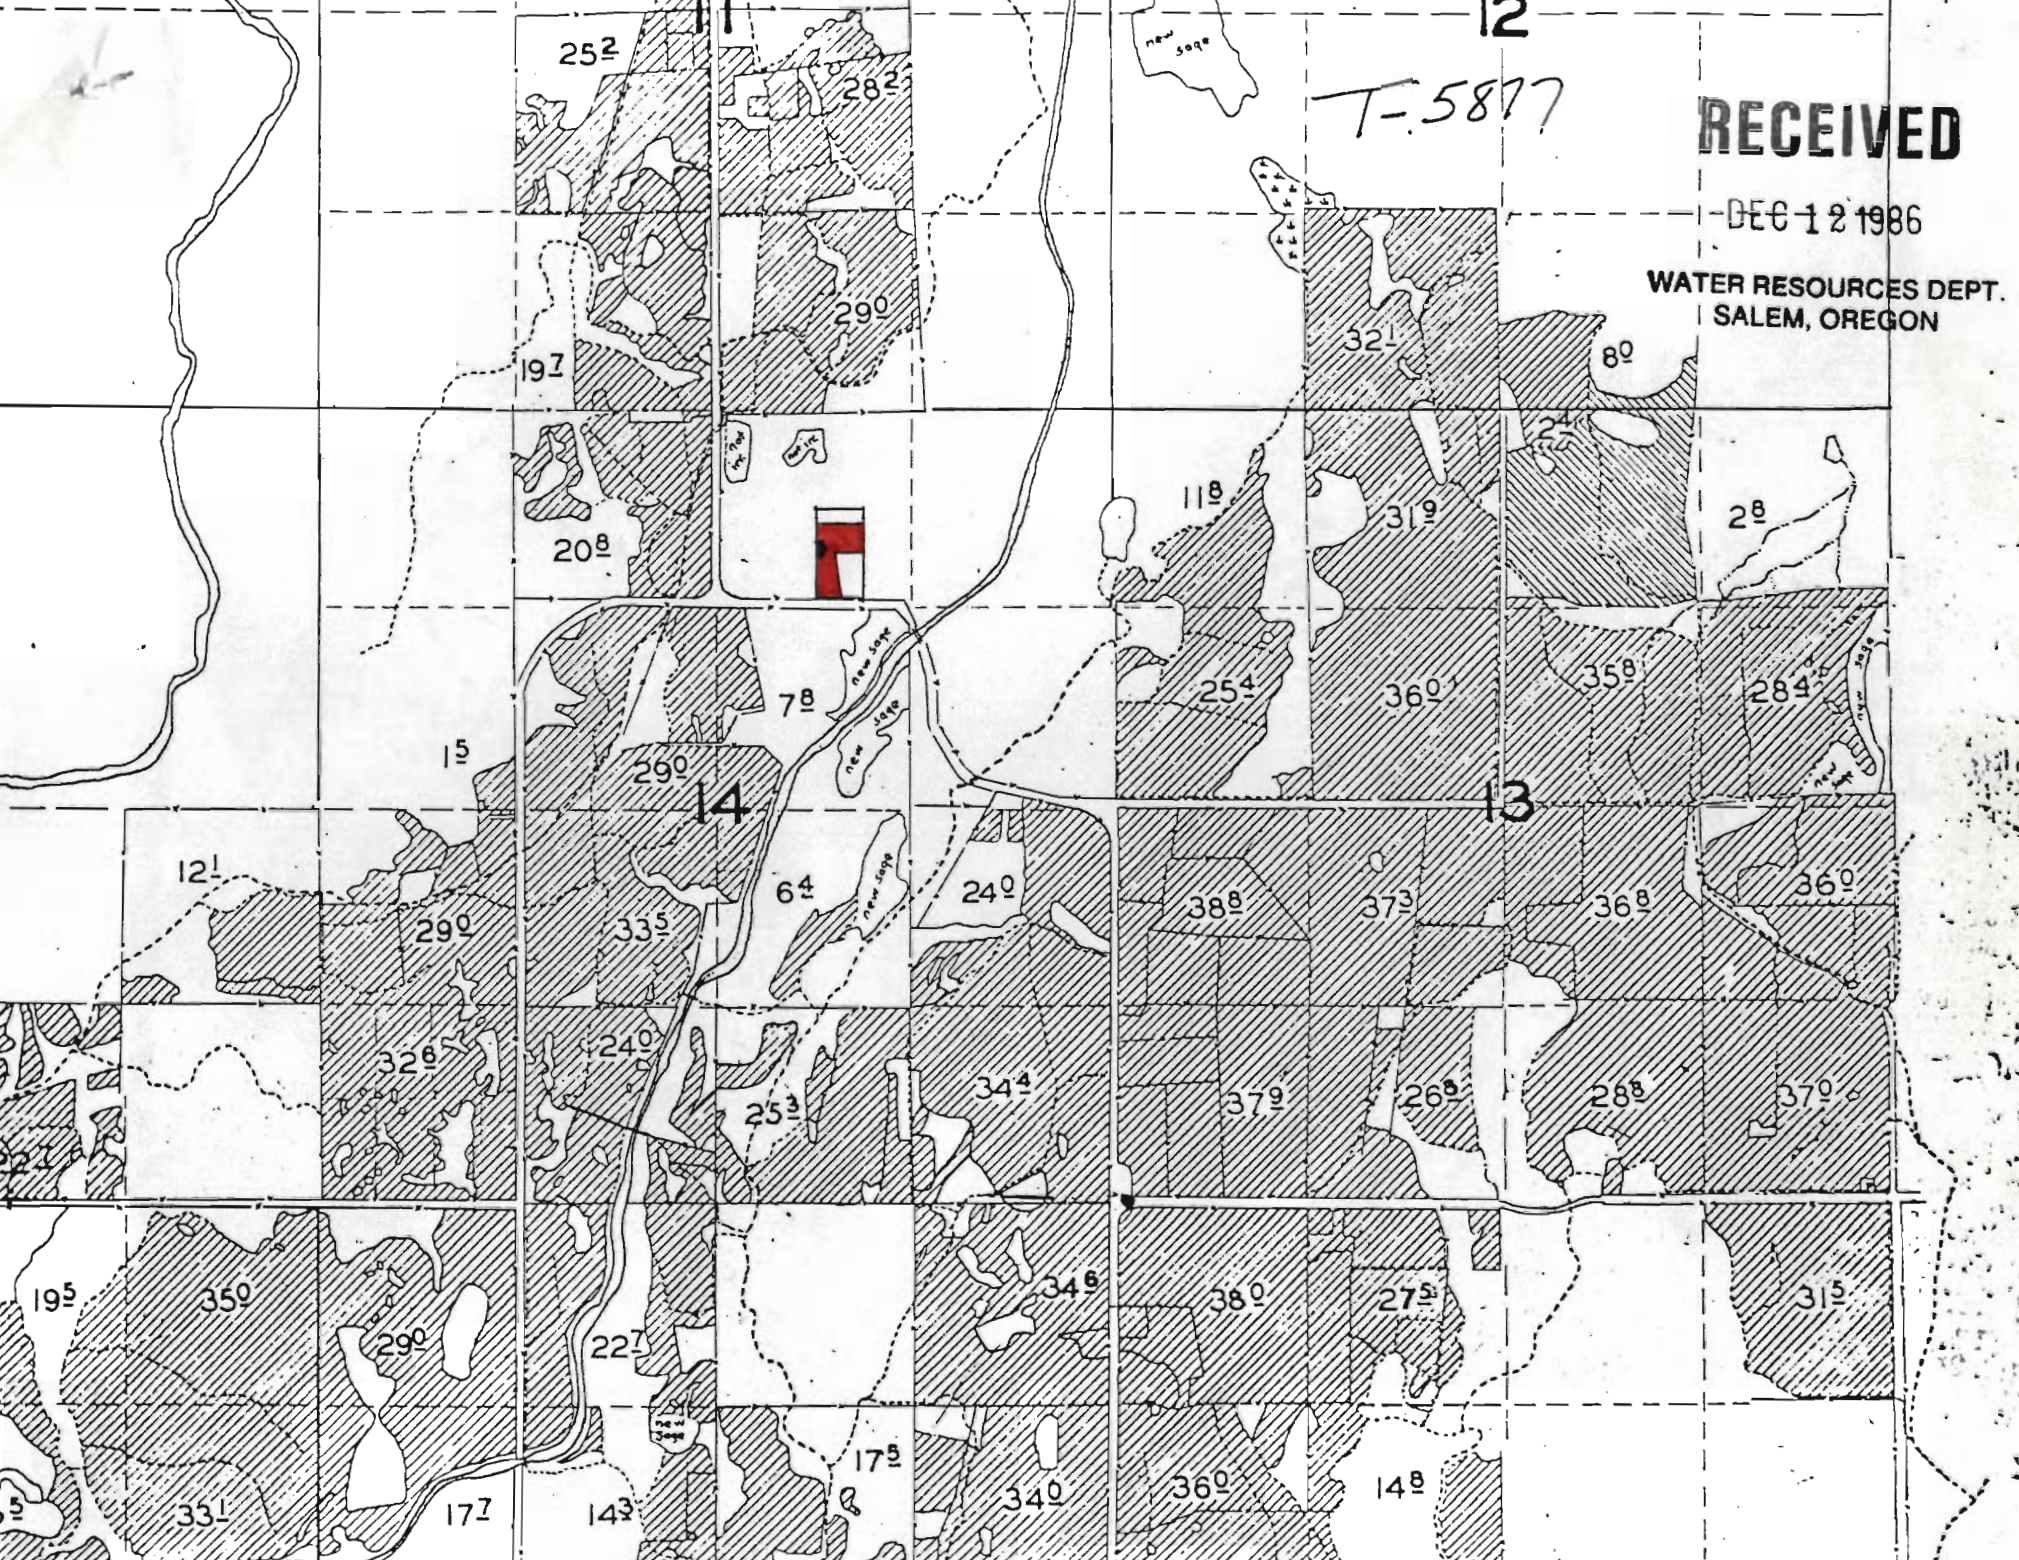

252

282

290

197

208

78

118

321

80

28

15

290

14

64

240

388

373

368

360

121

290

335

326

240

253

344

379

268

288

370

221

175

340

360

148

195

350

290

346

380

275

315

331

177

143

RECEIVED

DEC 12 1986

WATER RESOURCES DEPT.
SALEM, OREGON

T-5877

12

13

new sage



new lake

new sage

new sage