


T.9S. R.2W. W.M.

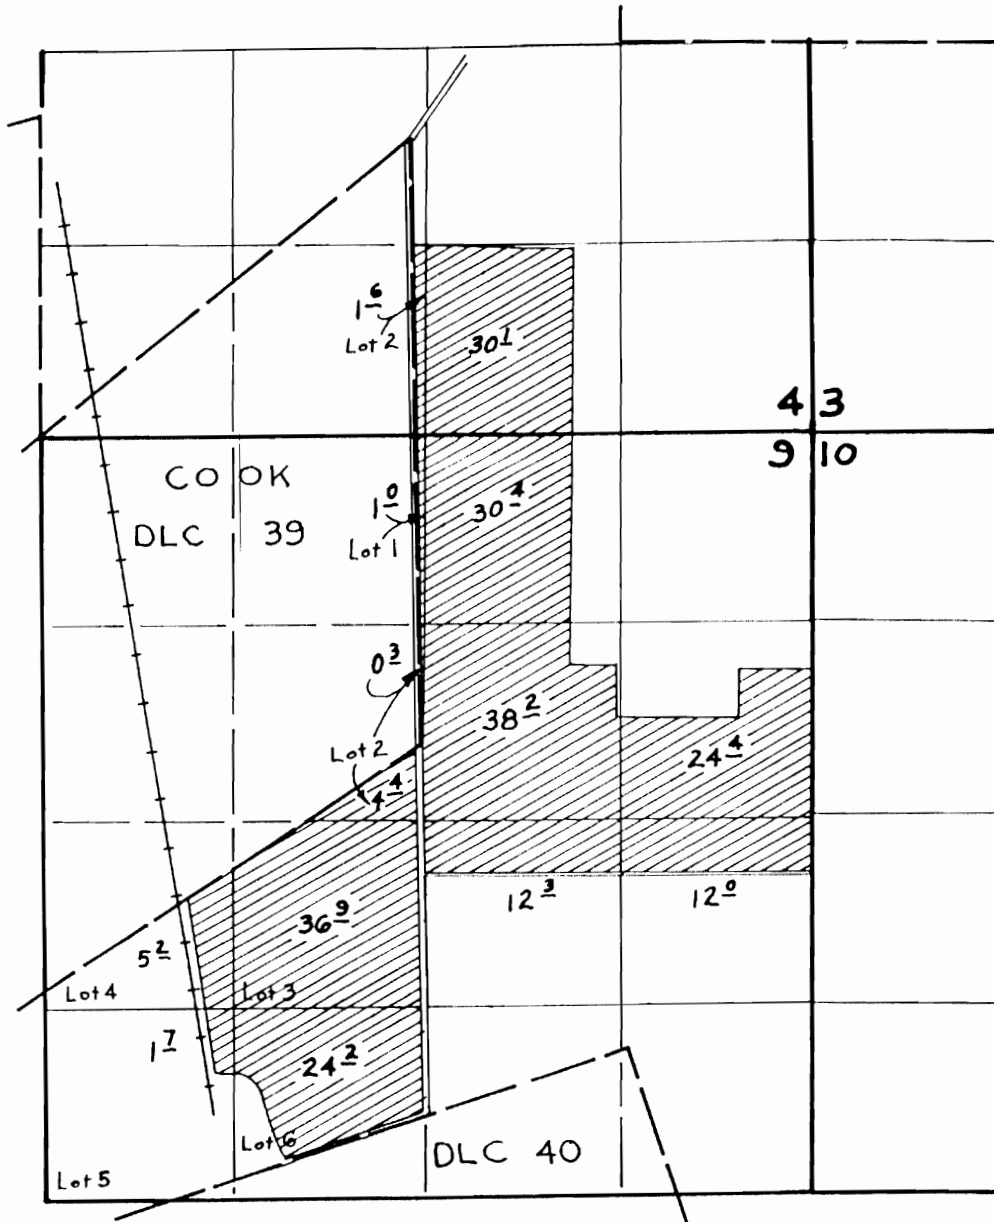

### FINAL PROOF SURVEY

UNDER

Application No. E-81 Permit No. E-82

IN NAME OF

**ROBERT DOERFLER**

Surveyed MAY 30 19 78, by L. NUNN