


T.9S. R.1W. W.M.

Park #1

91713-141 - Truss street
91713-131

Park #2 - north part

91714-031 - City of Stayton (road)
91714-010 - SIP

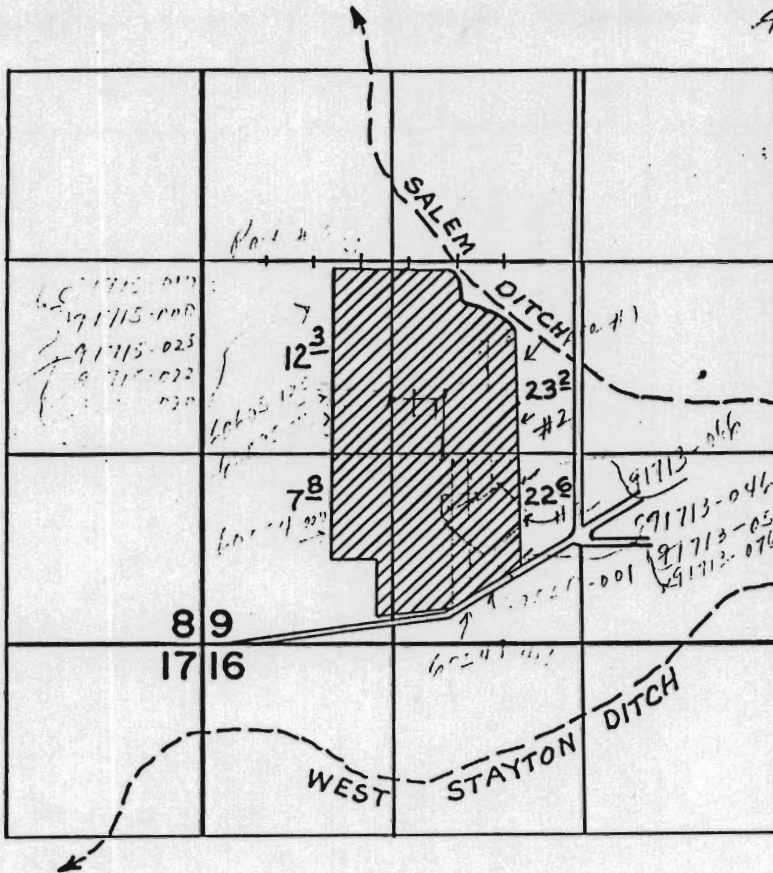

91714-001 - Wency Ave.
91713-121 - STP/Wagner
91713-161 (may have
1' x 60' been combined
with 91713-121)

See map -
knowledge of
west part of
Park #2 - Stayton
9171-280
9171-150
6027-500
9171-603
1224
in station

FINAL PROOF SURVEY

UNDER

Application No. 1508 Permit No. 1401

IN NAME OF

STAYTON INDUSTRIAL PROPERTIES

Surveyed JUL 13, 1978, by L. NUNN