


T5S RIW WM

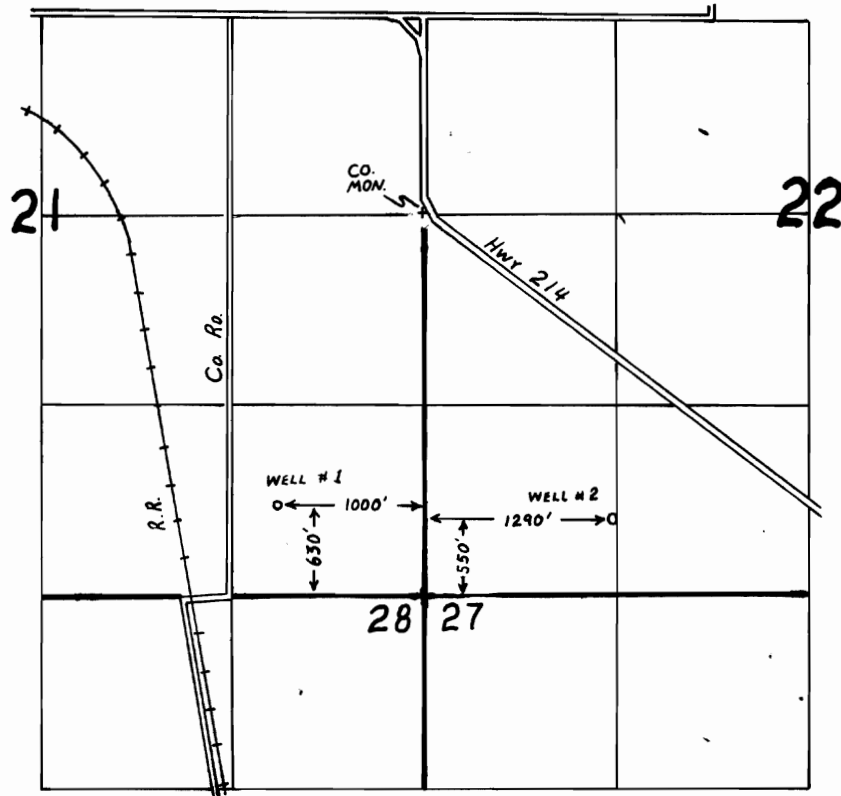

FINAL PROOF SURVEY

UNDER

Transfer No. 5889...

Application No. Permit No.

IN NAME OF

..... *ROBERT F. FESSLER*

Surveyed *Apr. 23*... 19*89*., by *R. W. KLASSEN*.....