


T.18S.,R.2&3W, W. M.

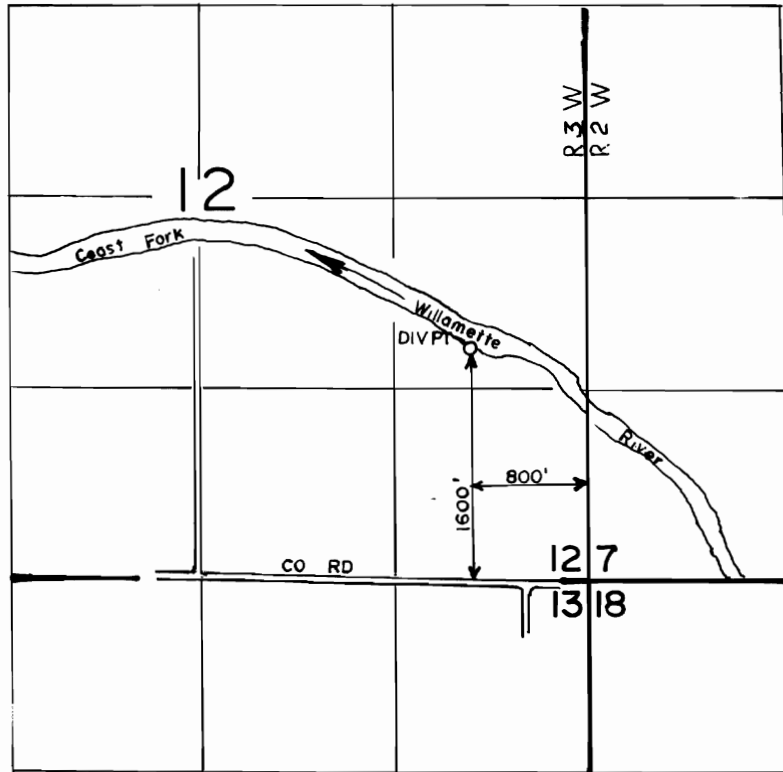

**FINAL PROOF SURVEY
UNDER**

TRANSFER NO. 5899

Application No. Permit No.
IN NAME OF

.....**JAMES D. EVONUK**.....

Surveyed JUNE 13.. 19.90., by T.M. WARREN....