


1" = 400'

T-5901

16-11-22
T.V. 300

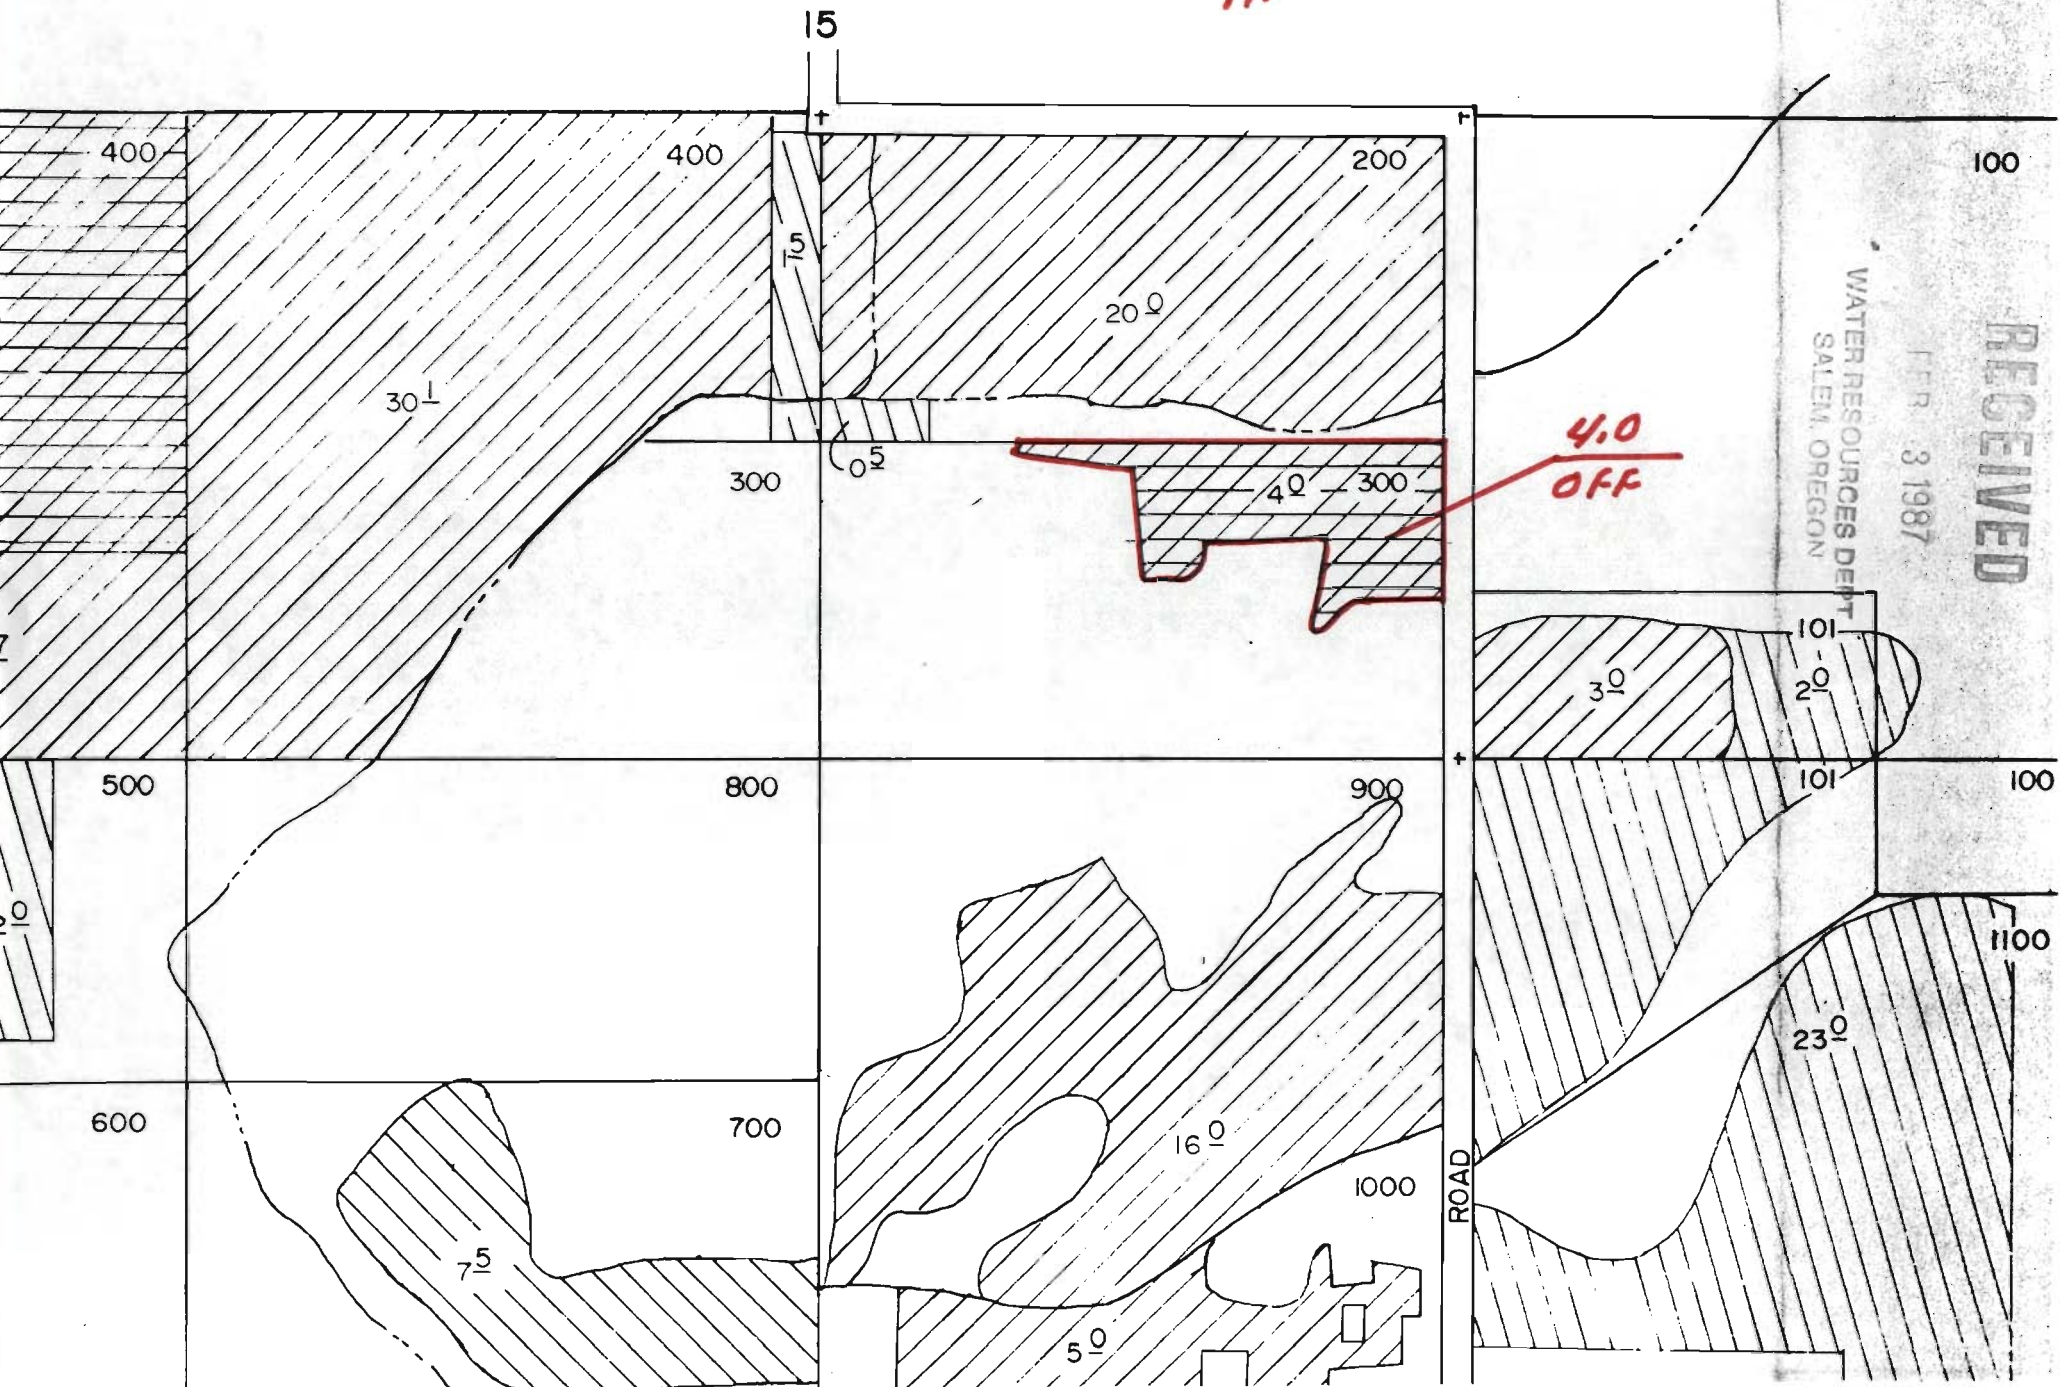



RECEIVED

FEB 3 1987

WATER RESOURCES DEPT
SALEM, OREGON

28

T-5901
16-11-27
T.V. 400

4.0
ON