

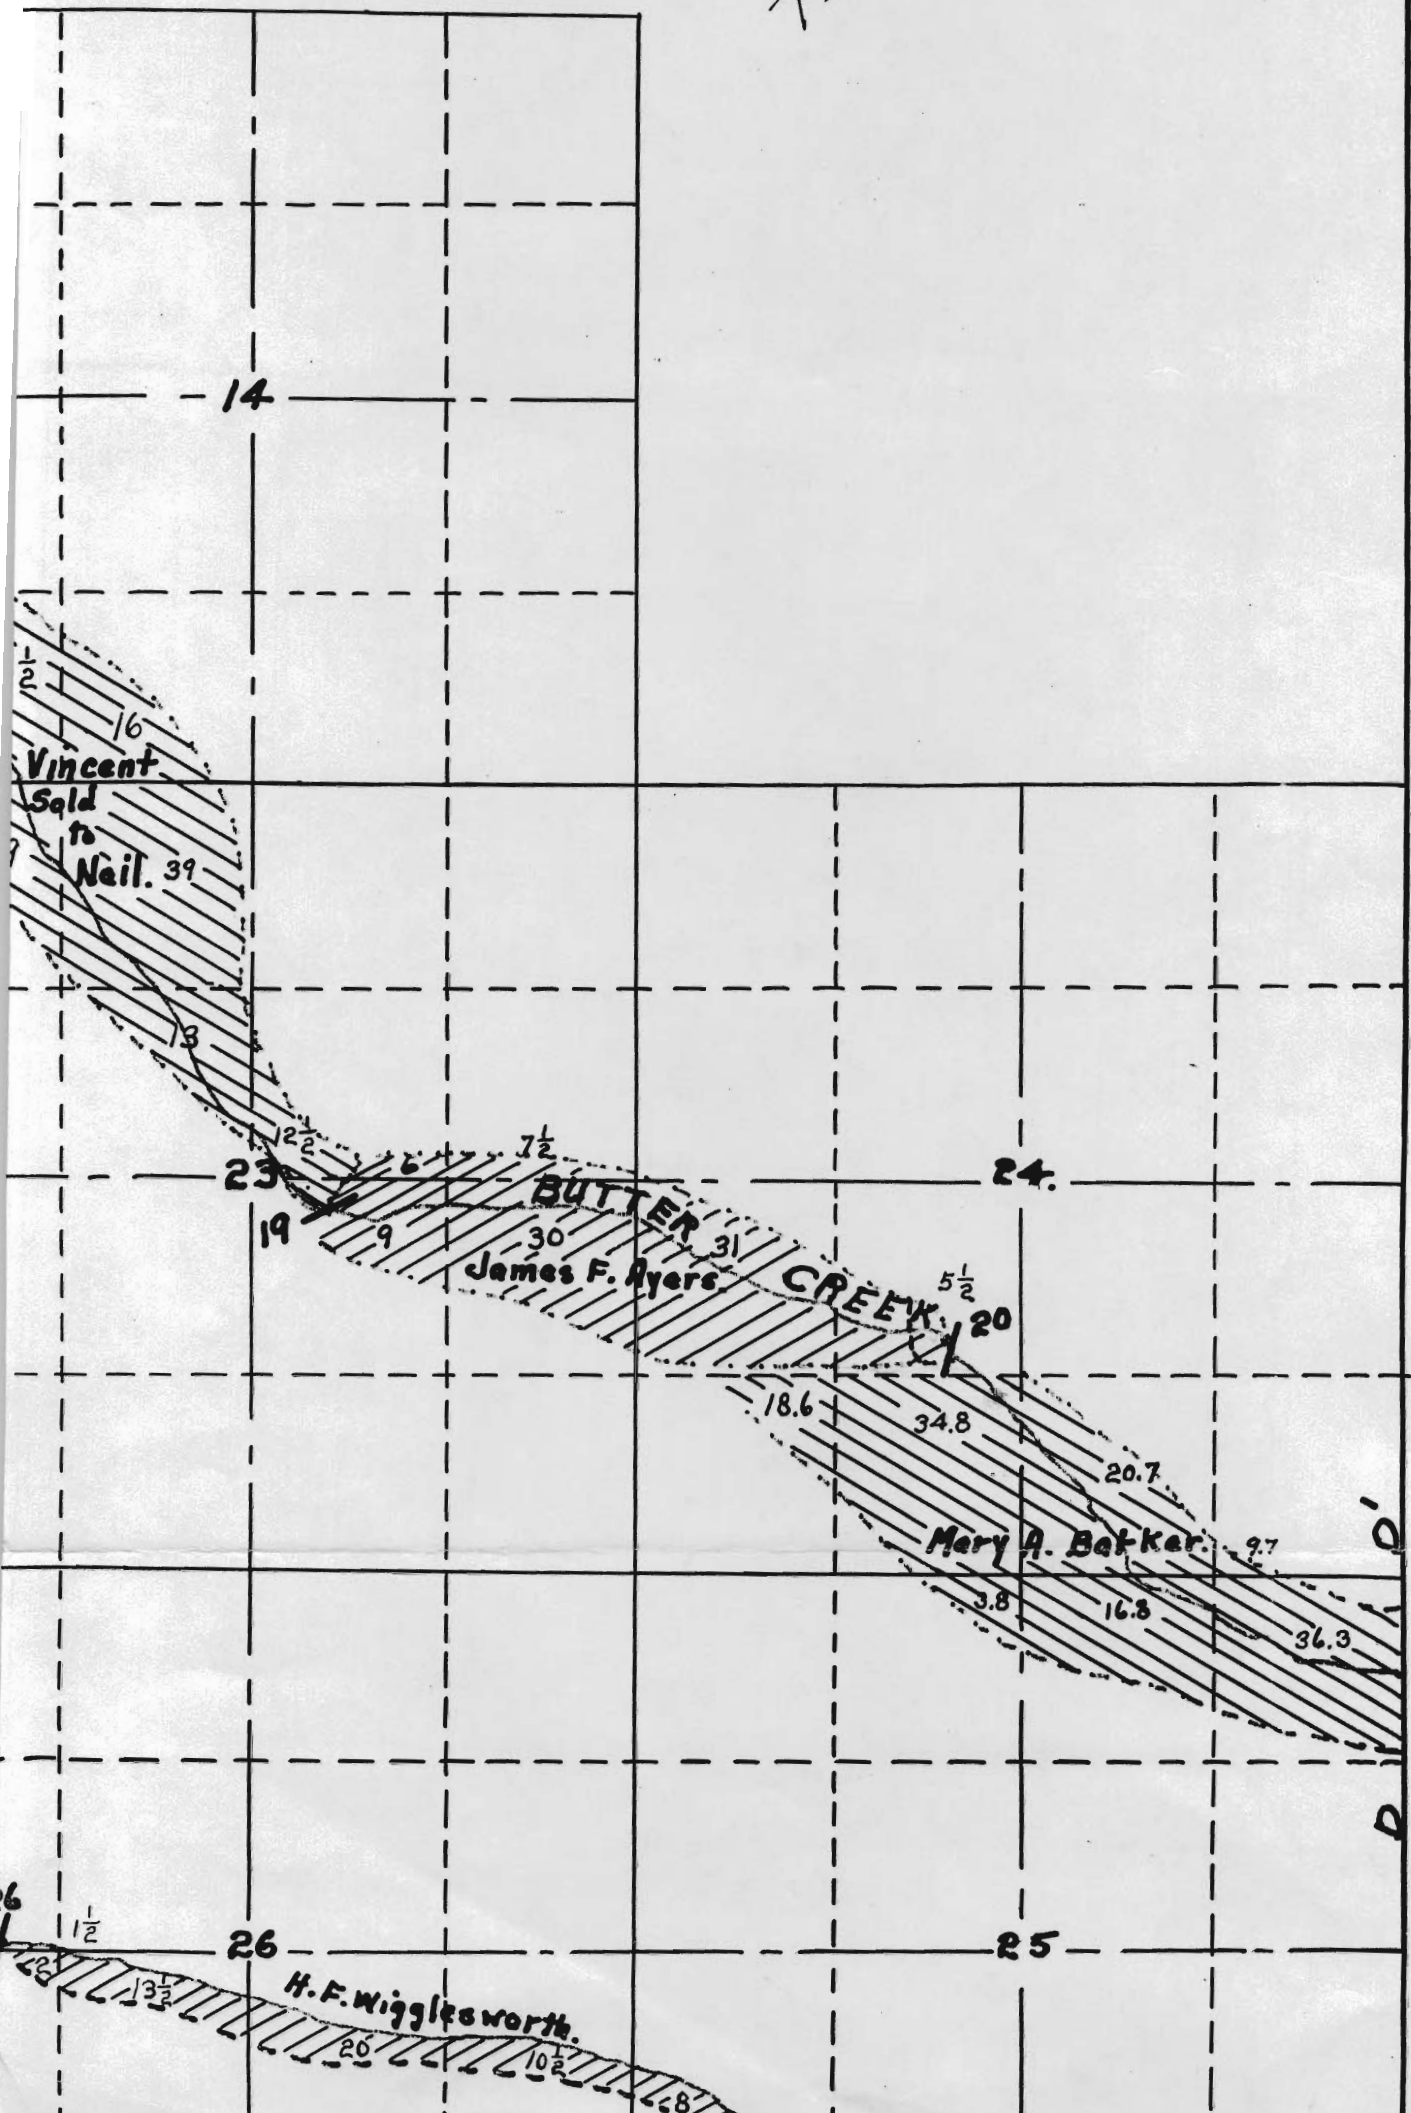


T-5911

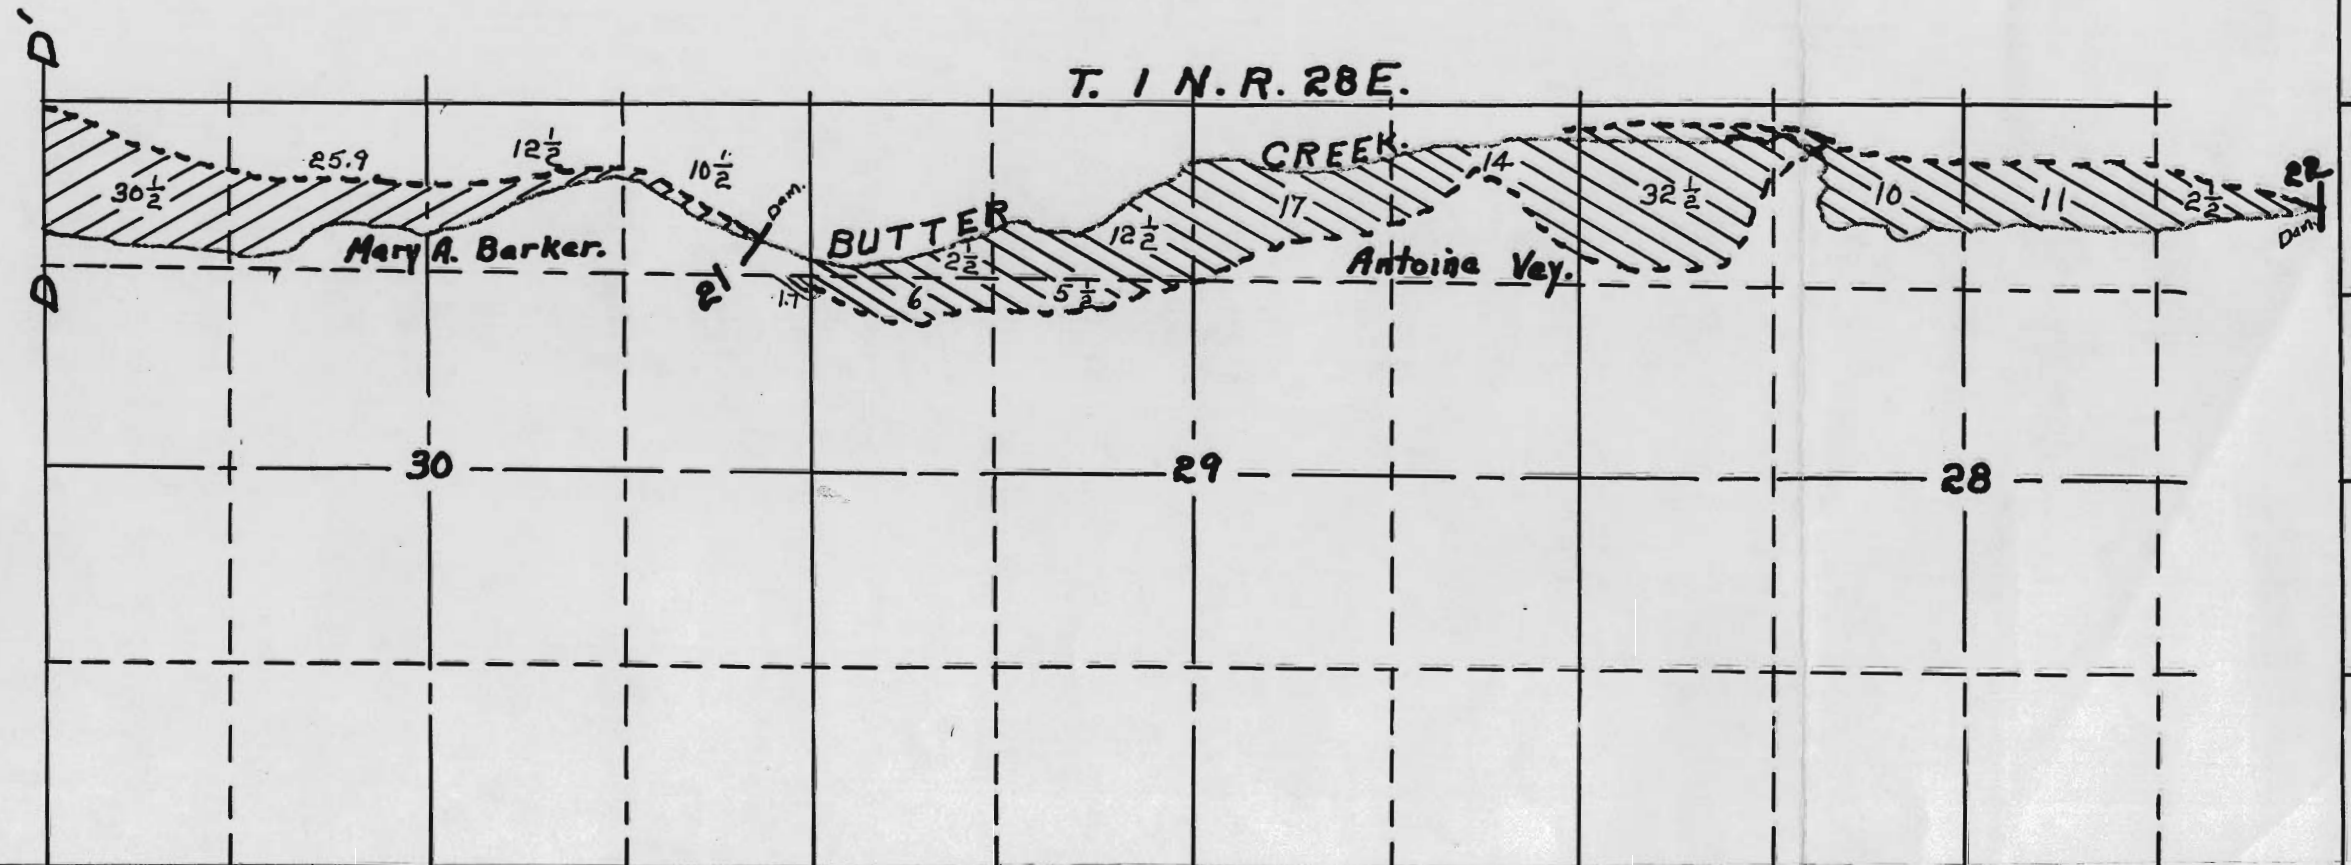

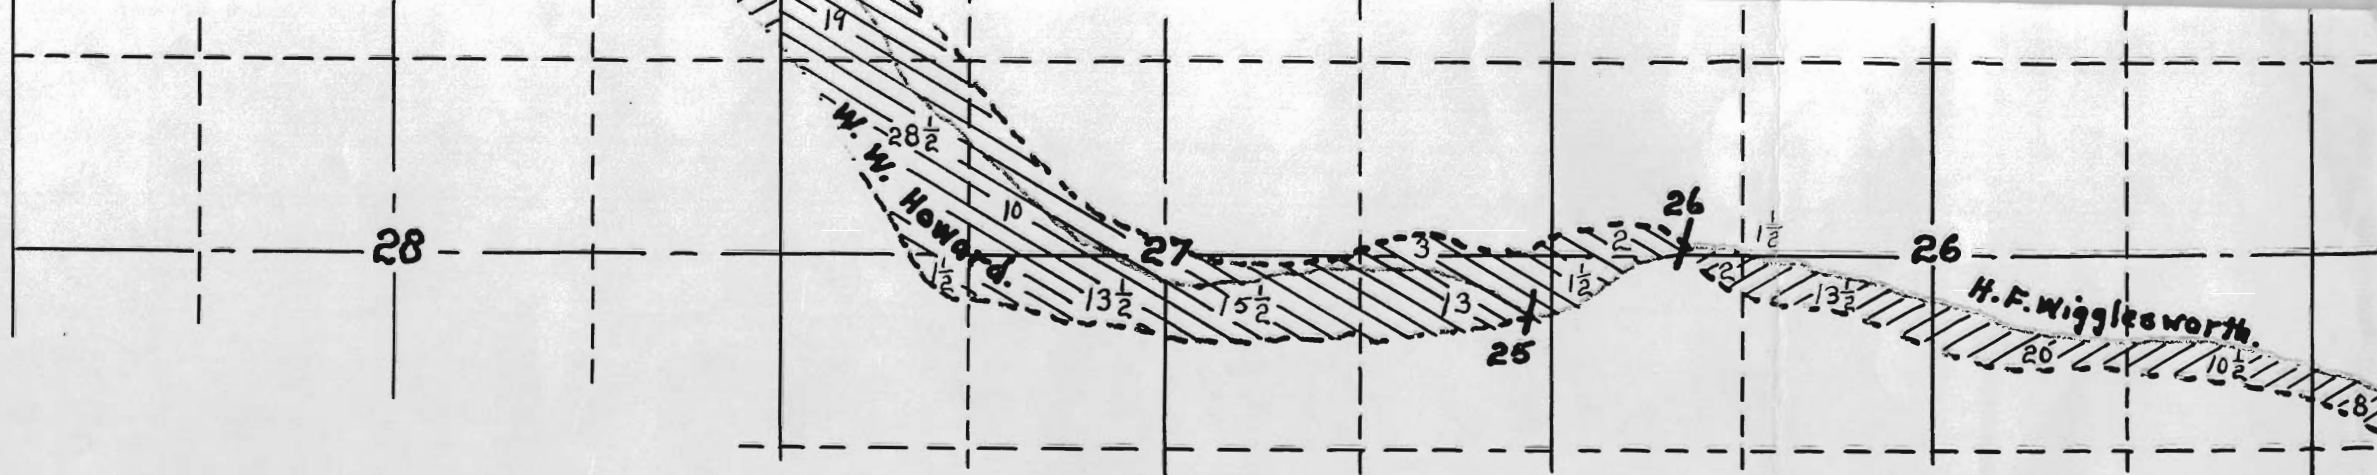

1165-1