


T. 32 S., R. 5 W., W. M.

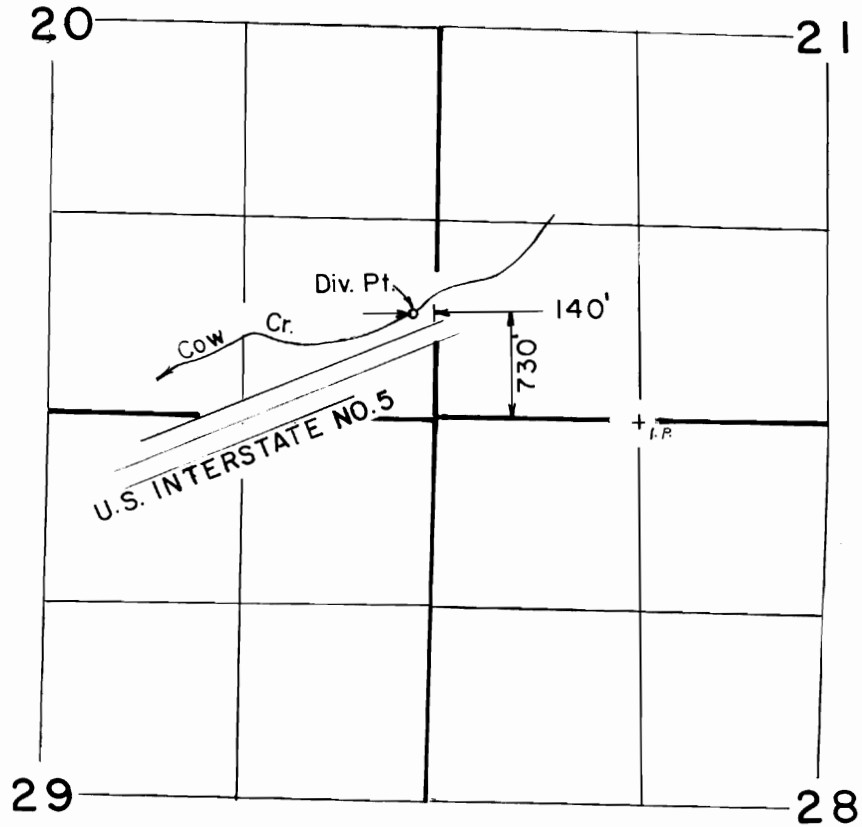

Scale: 1" = 1320'

FINAL PROOF SURVEY

UNDER

TRANSFER NO. 5916

Application No. Permit No.

IN NAME OF

.....HENRY & JOYCE A. PERRY.....

Surveyed OCT. 15, 1990, by B. S. JAMES