


# T. 36 S., R. 4 W., W. M.

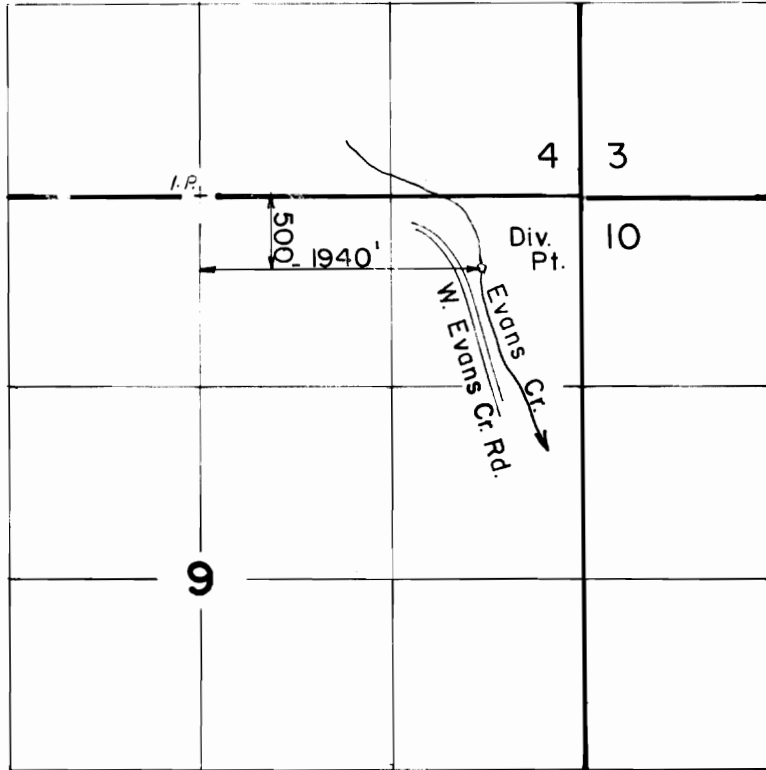

Scale : 1" = 1320'

## FINAL PROOF SURVEY UNDER

TRANSFER NO. 5925

Application No. .... Permit No. ....

IN NAME OF

..... LARRY E. PEEBLES .....

Surveyed JUNE 2... 1990., by L. M. JOACHIMS