


T. 38 S., R. 4 W., W. M.

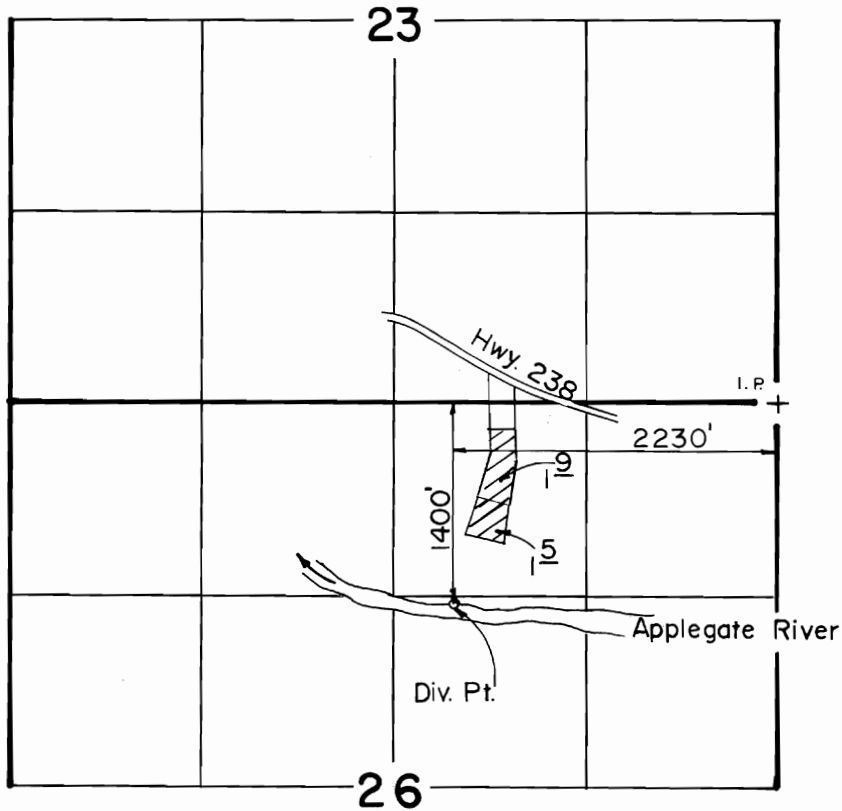

Scale: 1" = 1320'

FINAL PROOF SURVEY UNDER

TRANSFER NO. 5932

Application No. Permit No.

IN NAME OF

JIM YOUNG

Surveyed AUG...3... 19.88, by B...S...JAMES...