


# T. 36 S., R. 2 & 3 W., W. M.

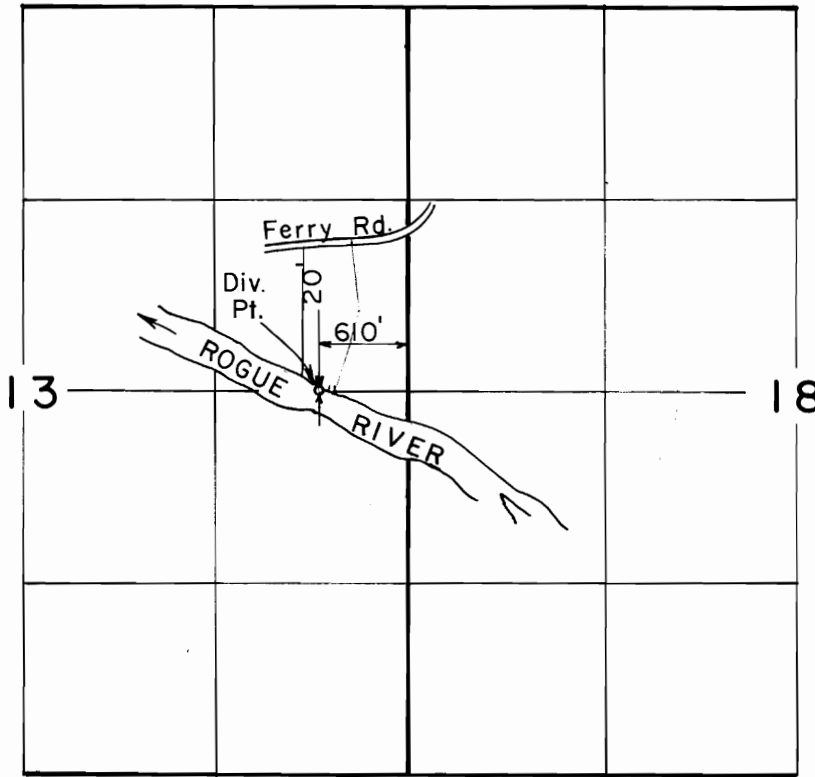

Scale: 1" = 1320'

## FINAL PROOF SURVEY UNDER

TRANSFER NO. 5933

Application No. .... Permit No. ....

IN NAME OF

...EDWARD & SUSAN CULVER...

Surveyed NOV. 7, 1990, by B. S. JAMES...