


T.37S.R.2W.W.M.

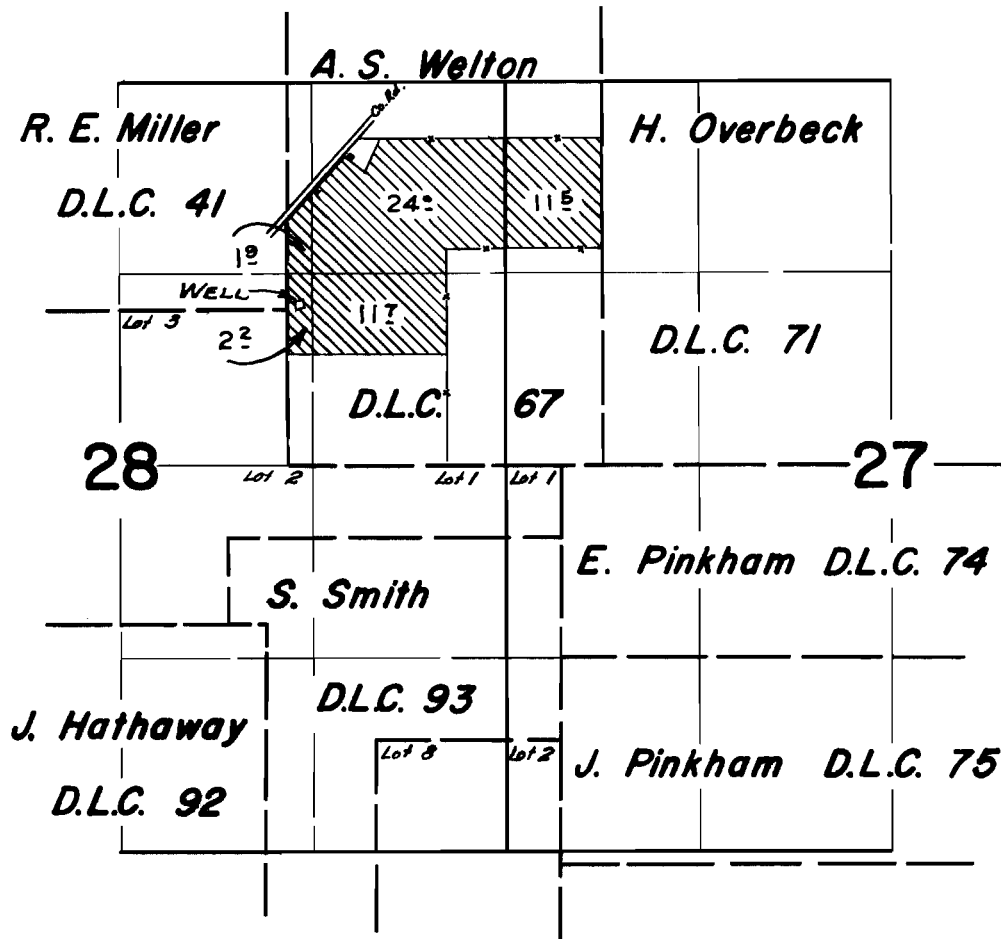

**FINAL PROOF SURVEY**  
UNDER

Application No. 6-1533 Permit No. 6-1421  
IN NAME OF

E. E. & ELLA MAE MCGREW

Surveyed May 14, 1963, by