


T.13S., R.33E., W.M.

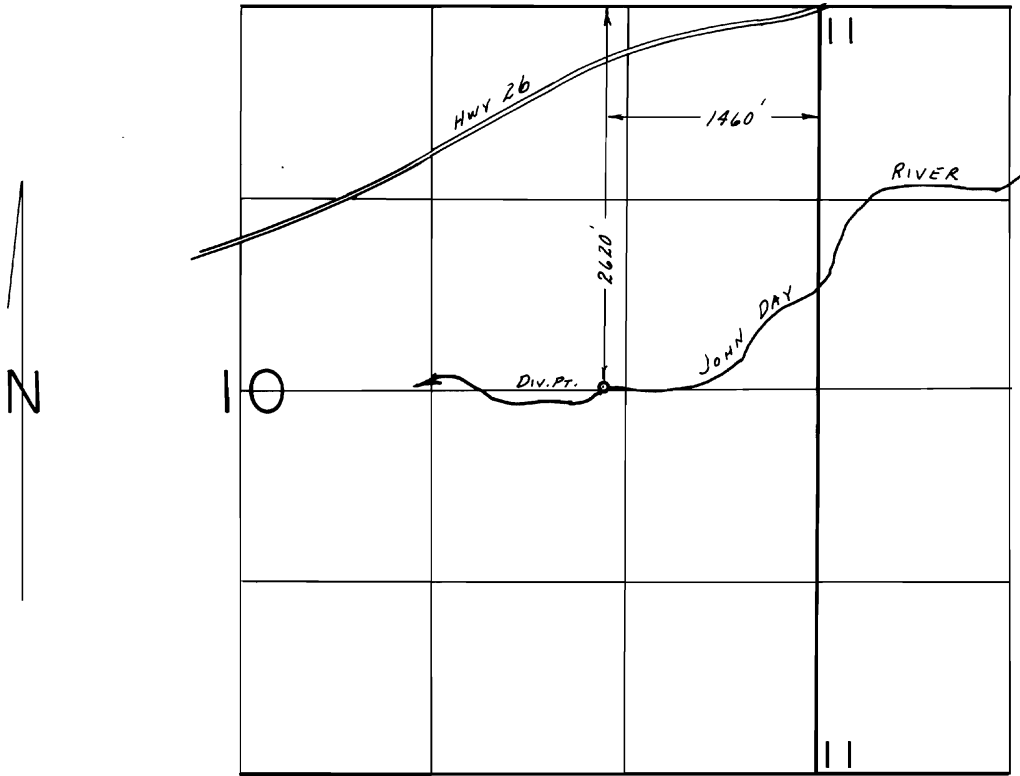

SCALE: 1" = 1320'

FINAL PROOF SURVEY
UNDER

Transfer No. 5969

IN NAME OF

.....ELMWOOD RANCHES.....

Surveyed June 17... 1988., by V.L. CHURCH.....