
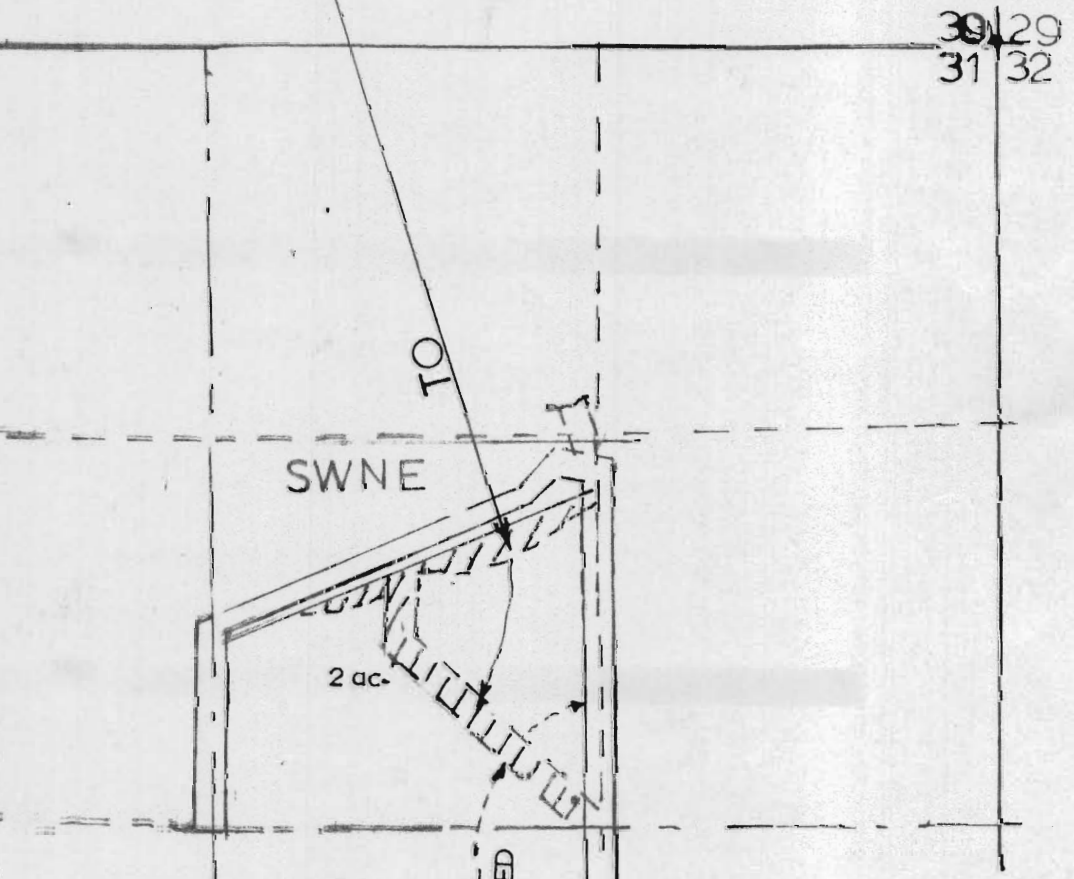
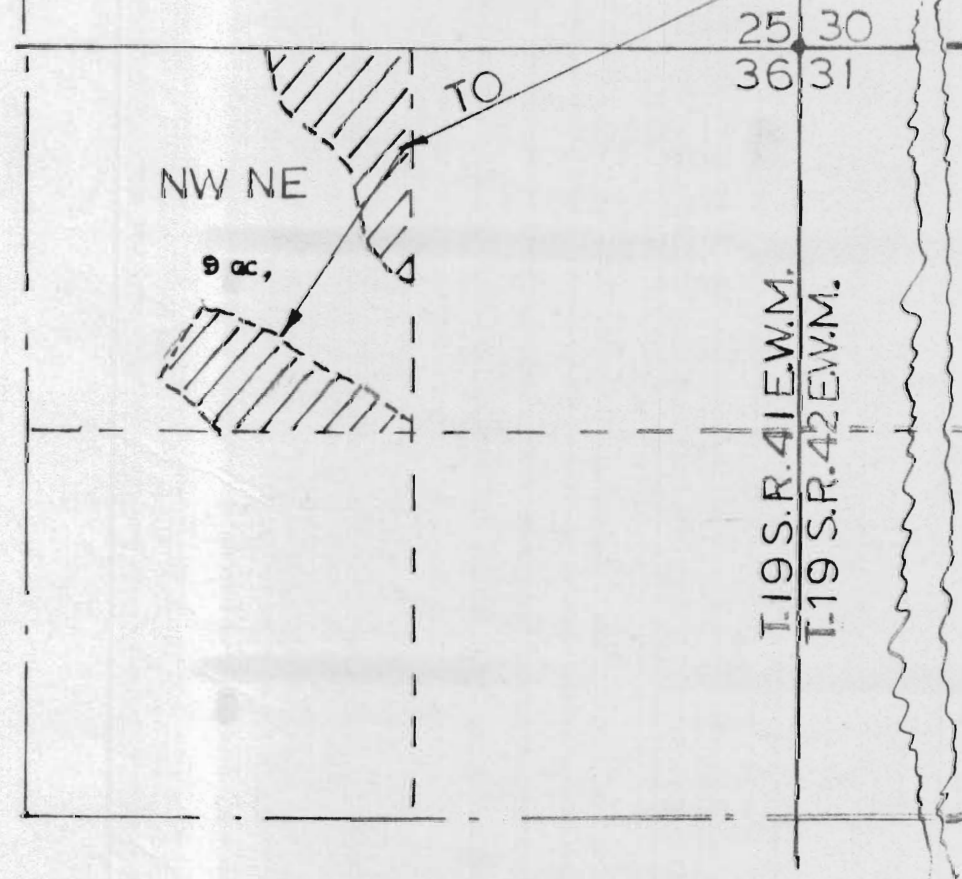
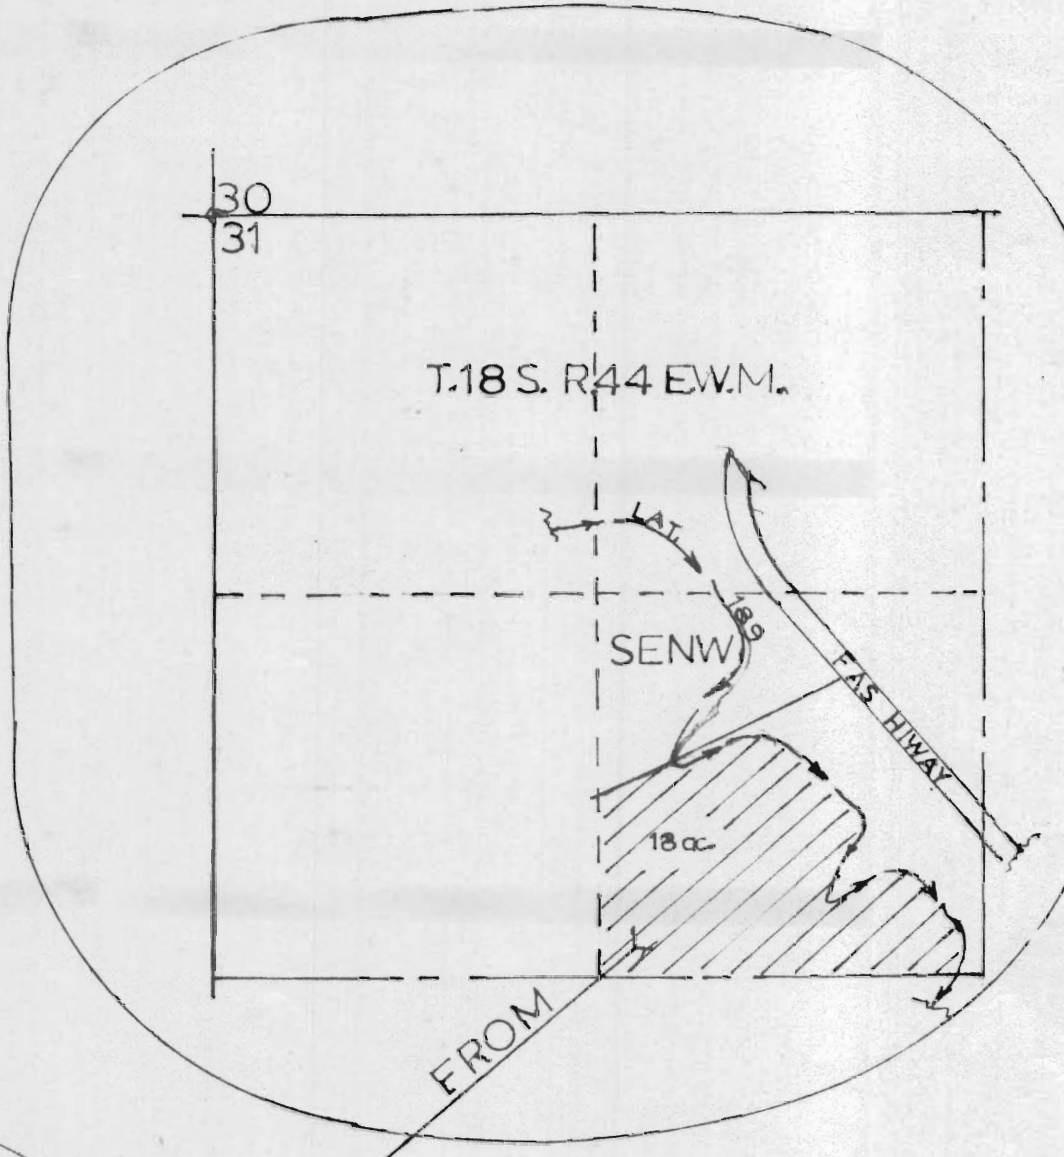


24 19  
25 30

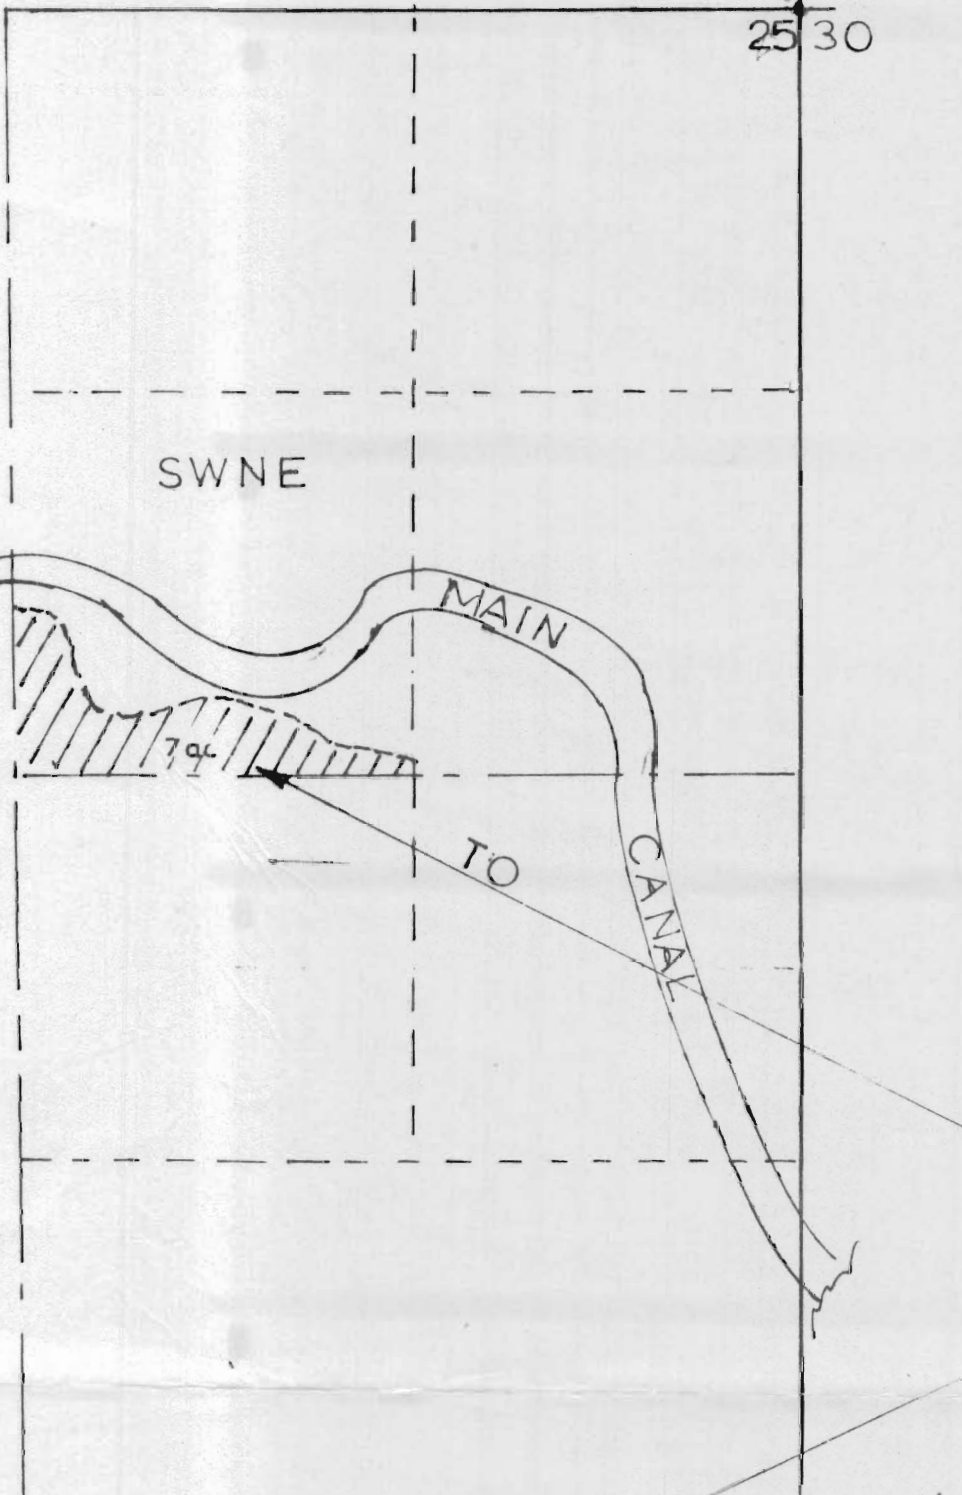

25 30  
36 31

30 29  
31 32

T.19 S. R. 41 E.W.M.  
T.19 S. R. 42 E.W.M.

APPLICATION FOR CHANGE IN PLACE OF USE  
Laurel Amick - Harper, Ore.

**RECEIVED**

NOV 18 1982

WATER RESOURCES DEPT.  
SALEM, OREGON

LATERAL  
RELOCATED

*Went 10/30/82*

F-5159