

T. 5N., R. 28E., W.M.

FINAL PROOF SURVEY

UNDER
TRANSFER 5285

IN NAME OF

AL and R.O. CONFORTH



SURVEYED JULY 11, 1989 by *V.H. Church*
JAN. 17, 2002
MAY 15, 2002



17 16

NE 1/4
NE 1/4

NW 1/4 NW 1/4
SCALE 1" = 400'

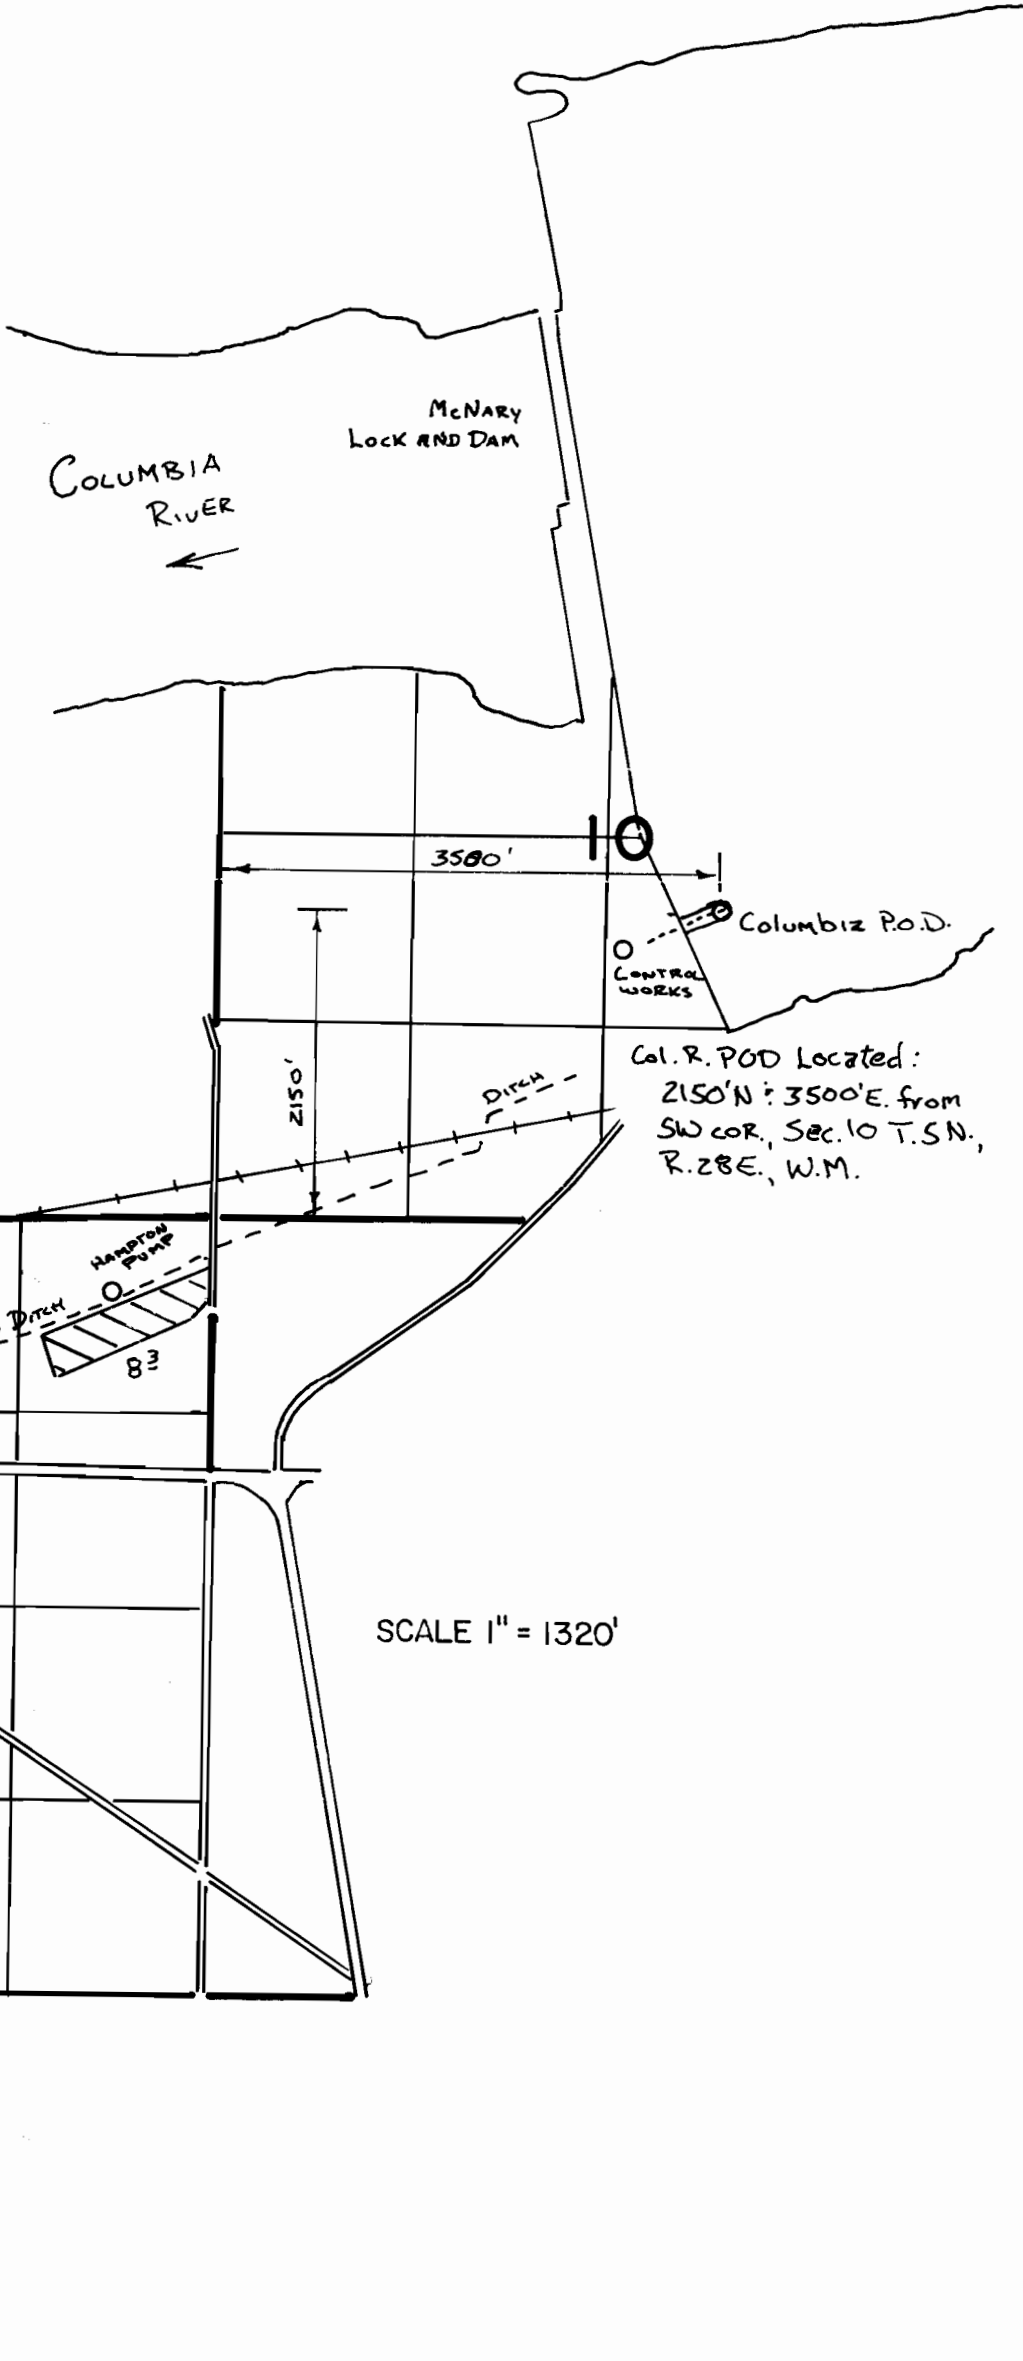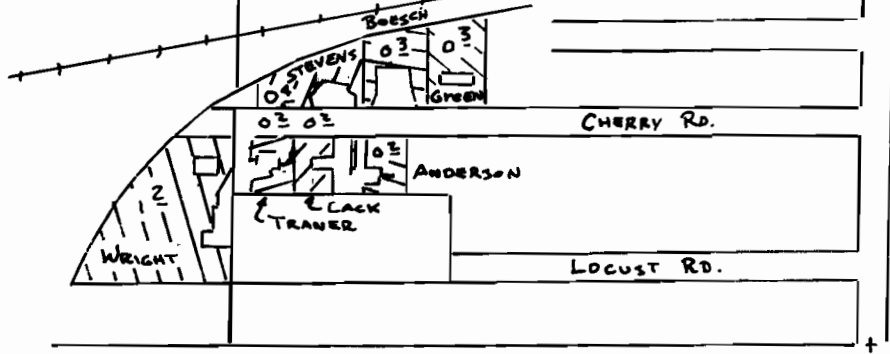

Col. R. P.O.D. Located:
2150' N + 3500' E. from
SW cor., Sec. 10 T. 5N.,
R. 28E., W.M.

SCALE 1" = 1320'

Umatilla River P.O.D.