


T-5307

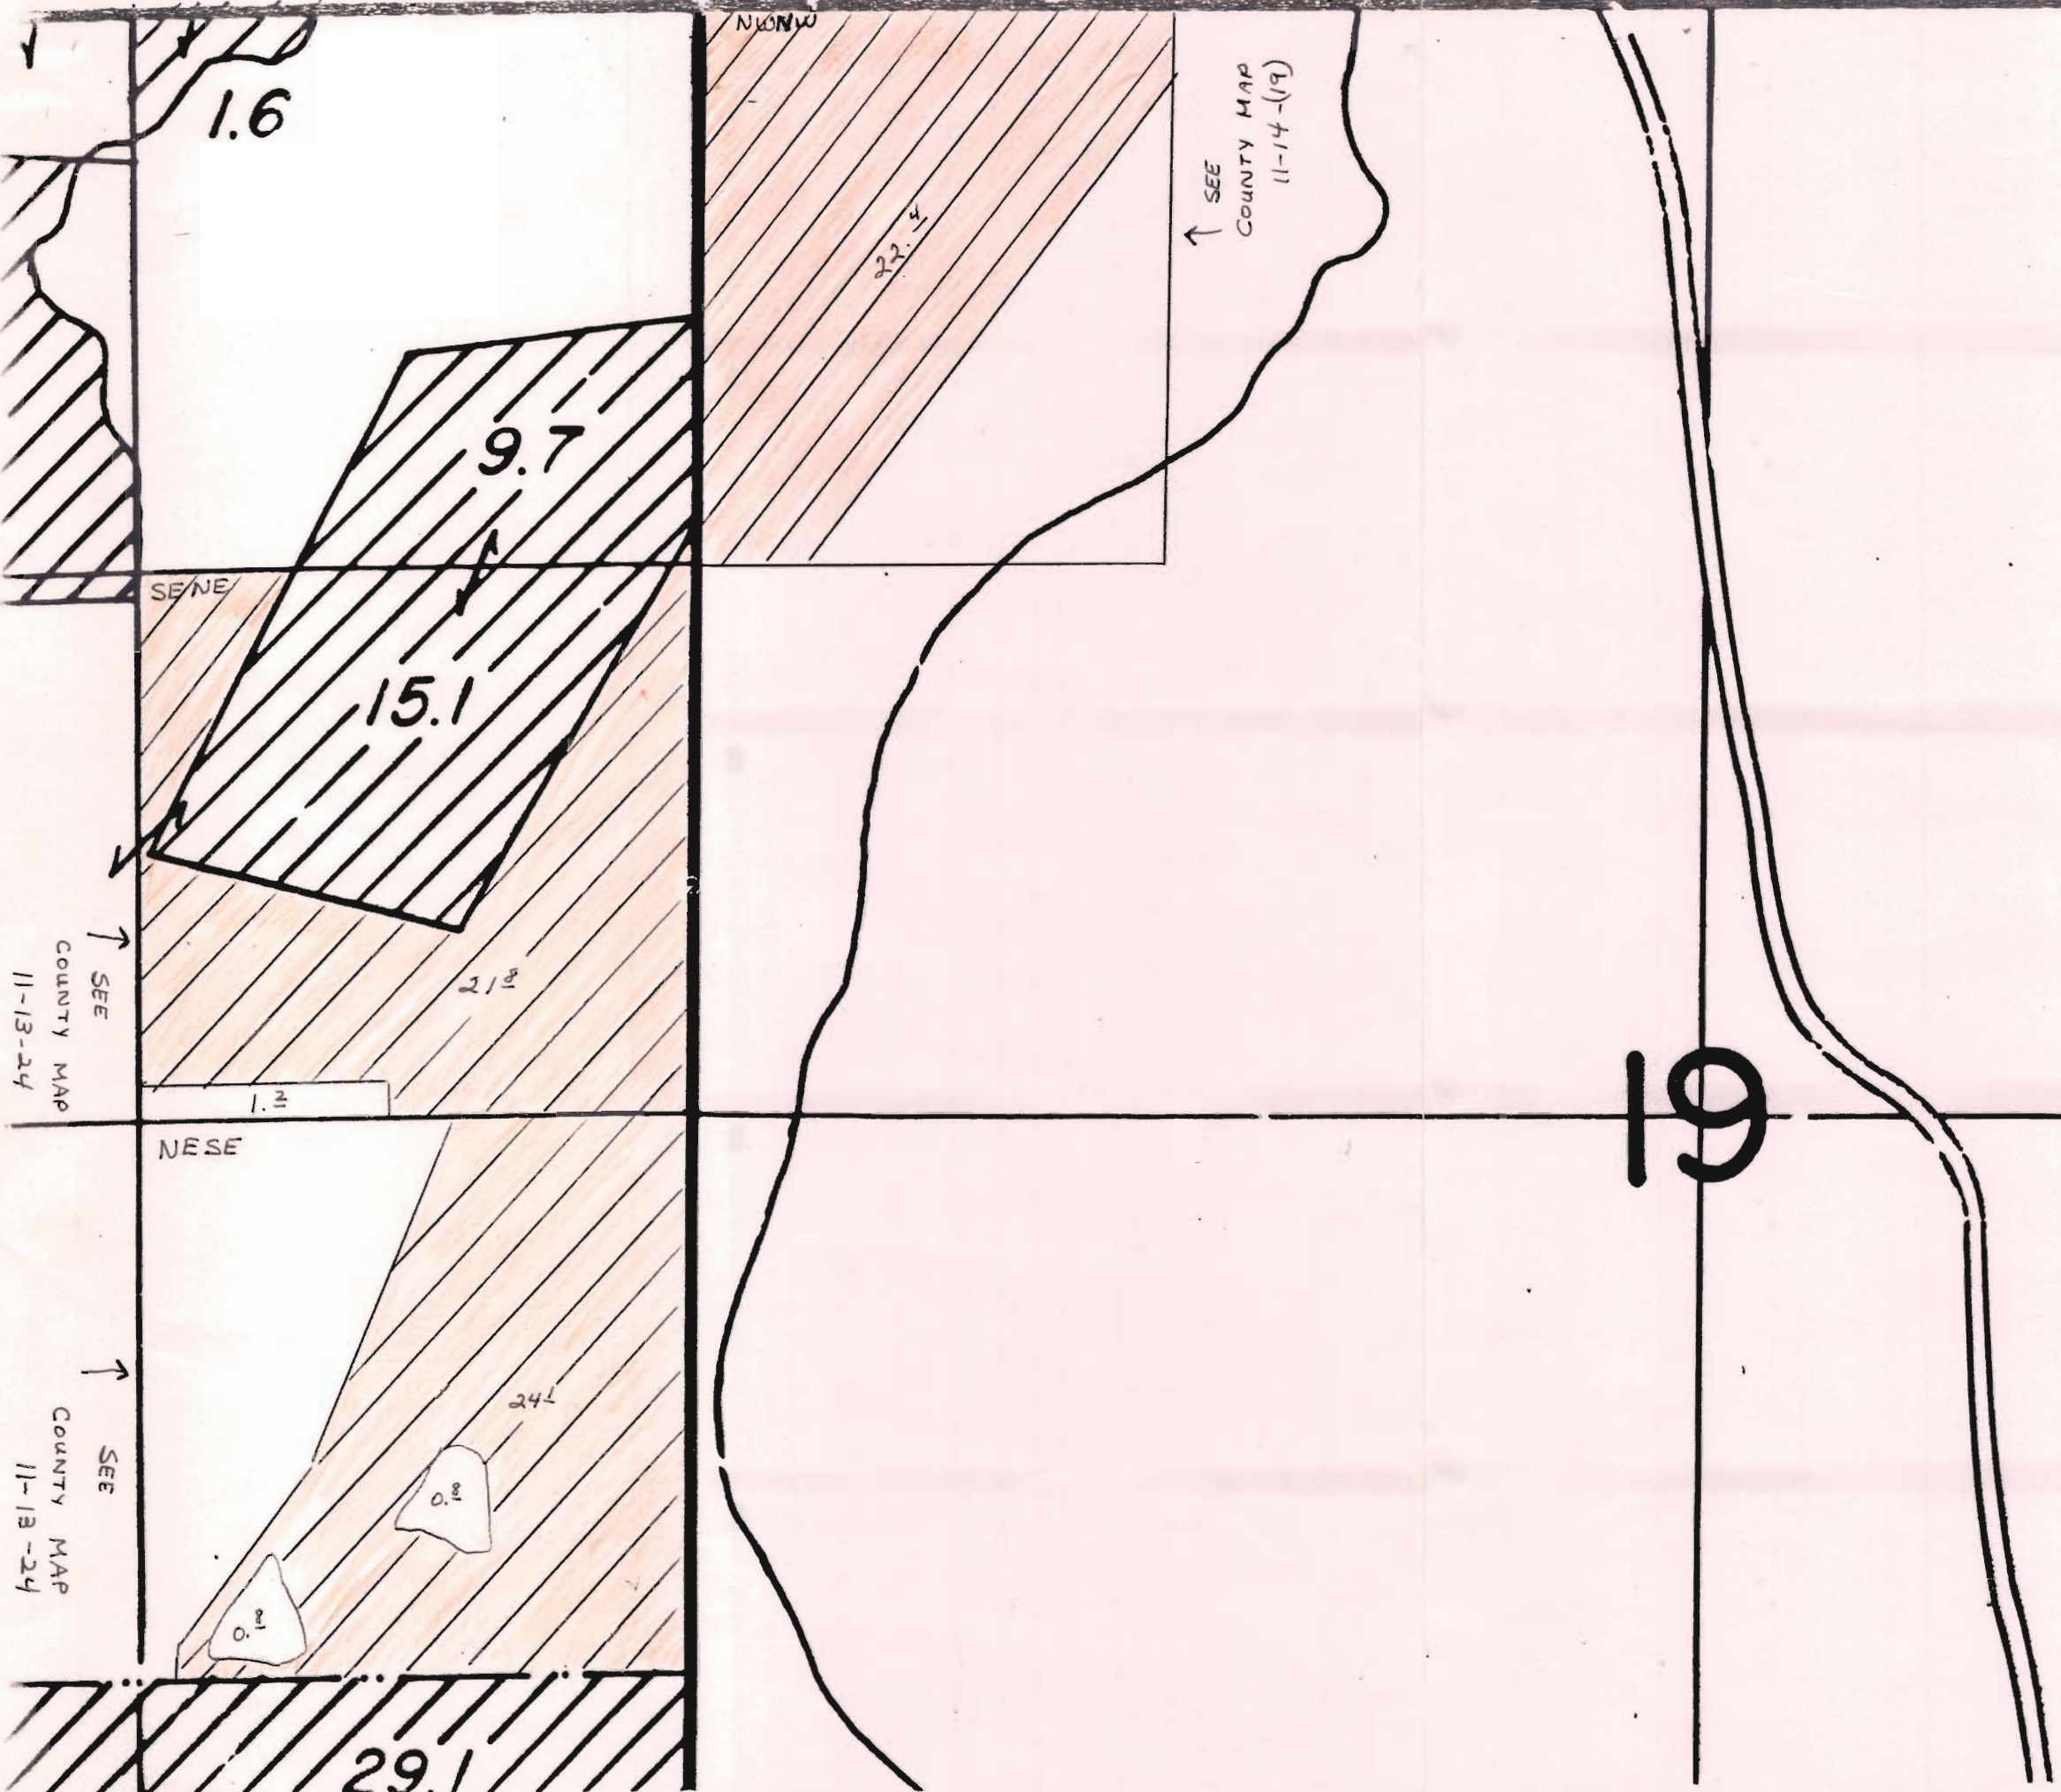

RECEIVED
 JUN 24 1983
 WATER RESOURCES DEPT.
 SALEM, OREGON

WATER RIGHTS
TO BE
REMOVED

T-5307

DELETE COOKED
RIVER RIGHTS

RECEIVED

JUN 24 1983
WATER RESOURCES DEPT.
SALEM, OREGON

