

FINAL PROOF SURVEY
UNDER

TRANSFER 5849

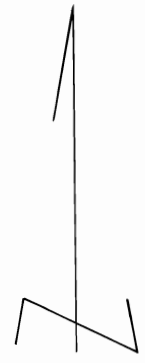
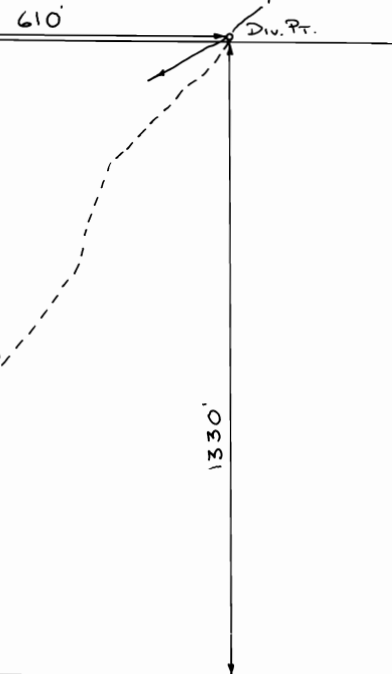
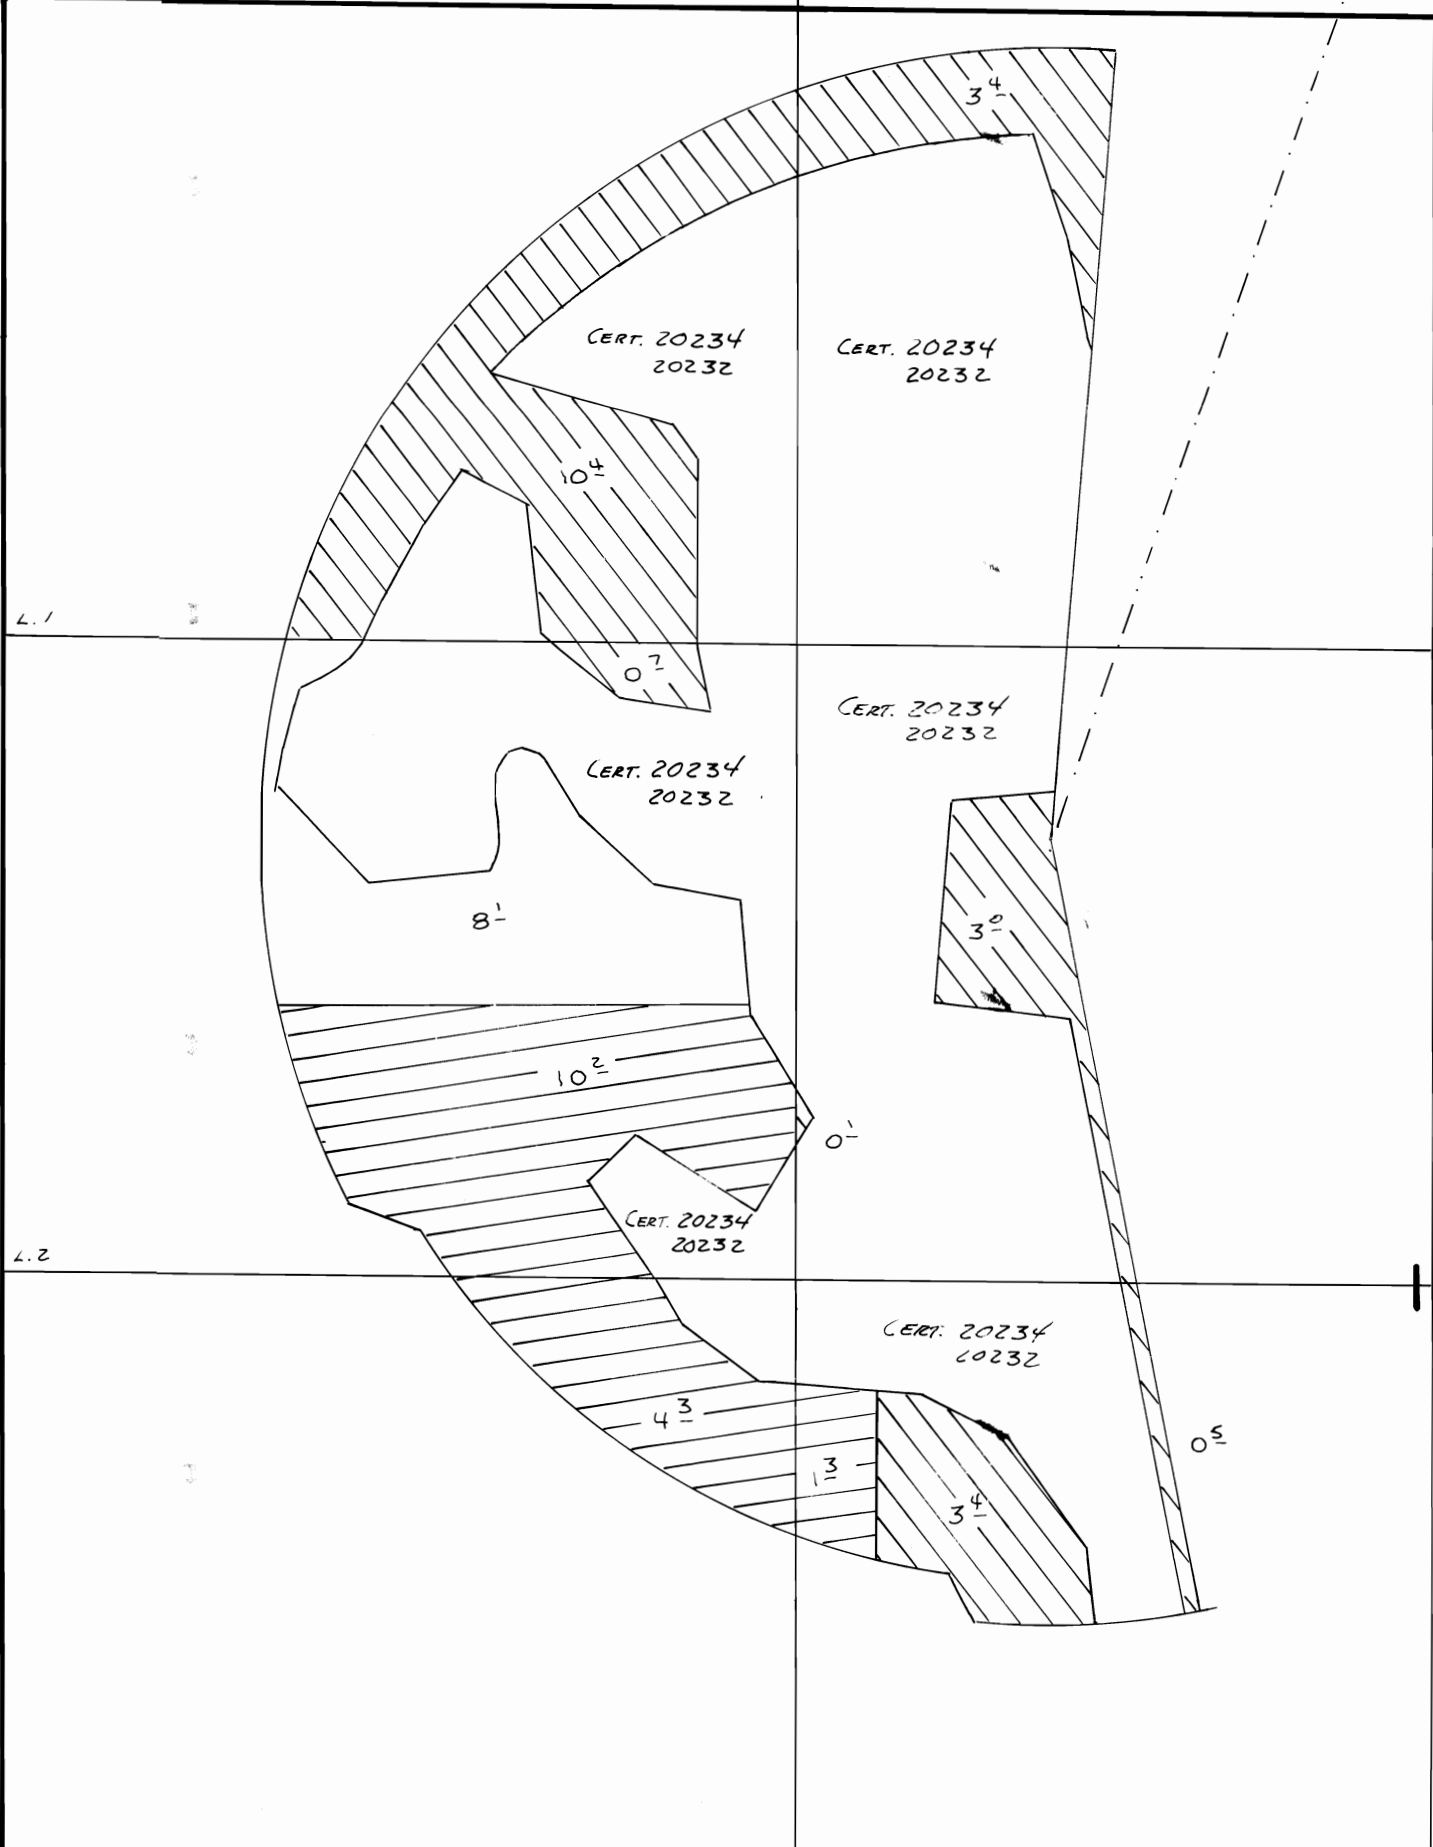
APPL. 68848 PER. 49909

IN NAME OF



LOVENESS FARMS

Surveyed 8-19, 1987, by V.L. CHURCH

7



SCALE 1" = 400'

-  T-5849
-  P# 49909