


FINAL PROOF SURVEY
 UNDER T-5999
 SEPTEMBER 22, 1990

27 | 26
 34 | 35

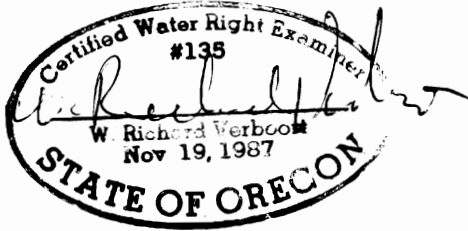

SEC. 35, T7S, R5W, WM
 POLK COUNTY
 SCALE 1"=400'


WATER RIGHT MAP
 FOR
 LINCOLN HORIZON, INC.
 DALLAS, OR.

PREPARATION OF THIS MAP IS FOR THE
 PURPOSE OF IDENTIFYING THE LOCATION OF
 THE WATER RIGHT ONLY. THERE IS NO INTENT
 TO PROVIDE DIMENSIONS OR LOCATION OF
 PROPERTY OWNERSHIP LINES.

W. RICHARD VERBOORT, P.E.
 CIVIL ENGINEER
 HILLSBORD, OREGON

TRANSFER FROM CERT. 34287 2.90 AC.
 TRANSFER FROM CERT. 21314 1.01 AC.

DM. POINT IS LOCATED 420' E.
 & 390' S. FROM N.E. CORNER DLCC66

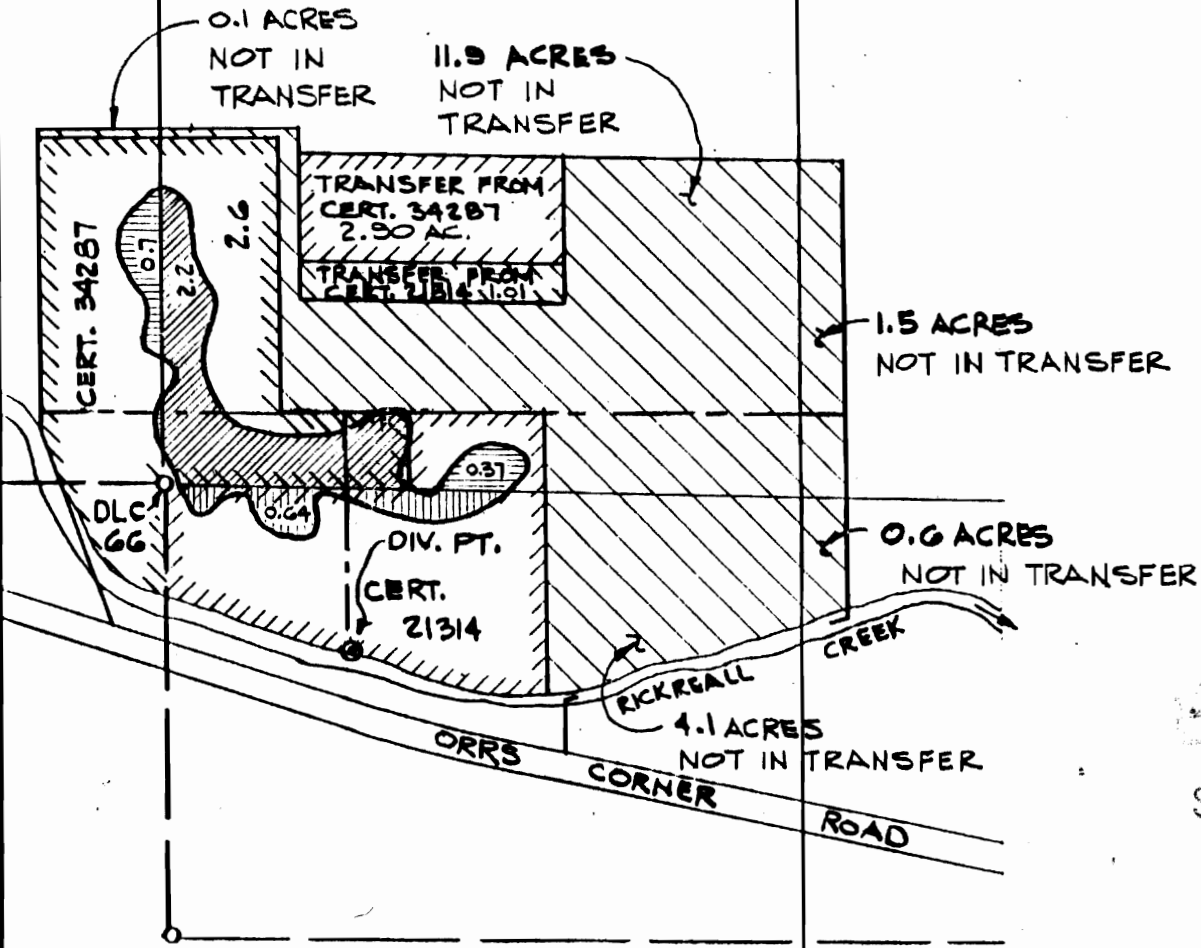

RECEIVED

SEP 25 1990

RECORDS
 DEPT. OF AGRICULTURE
 OREGON