


T-6007

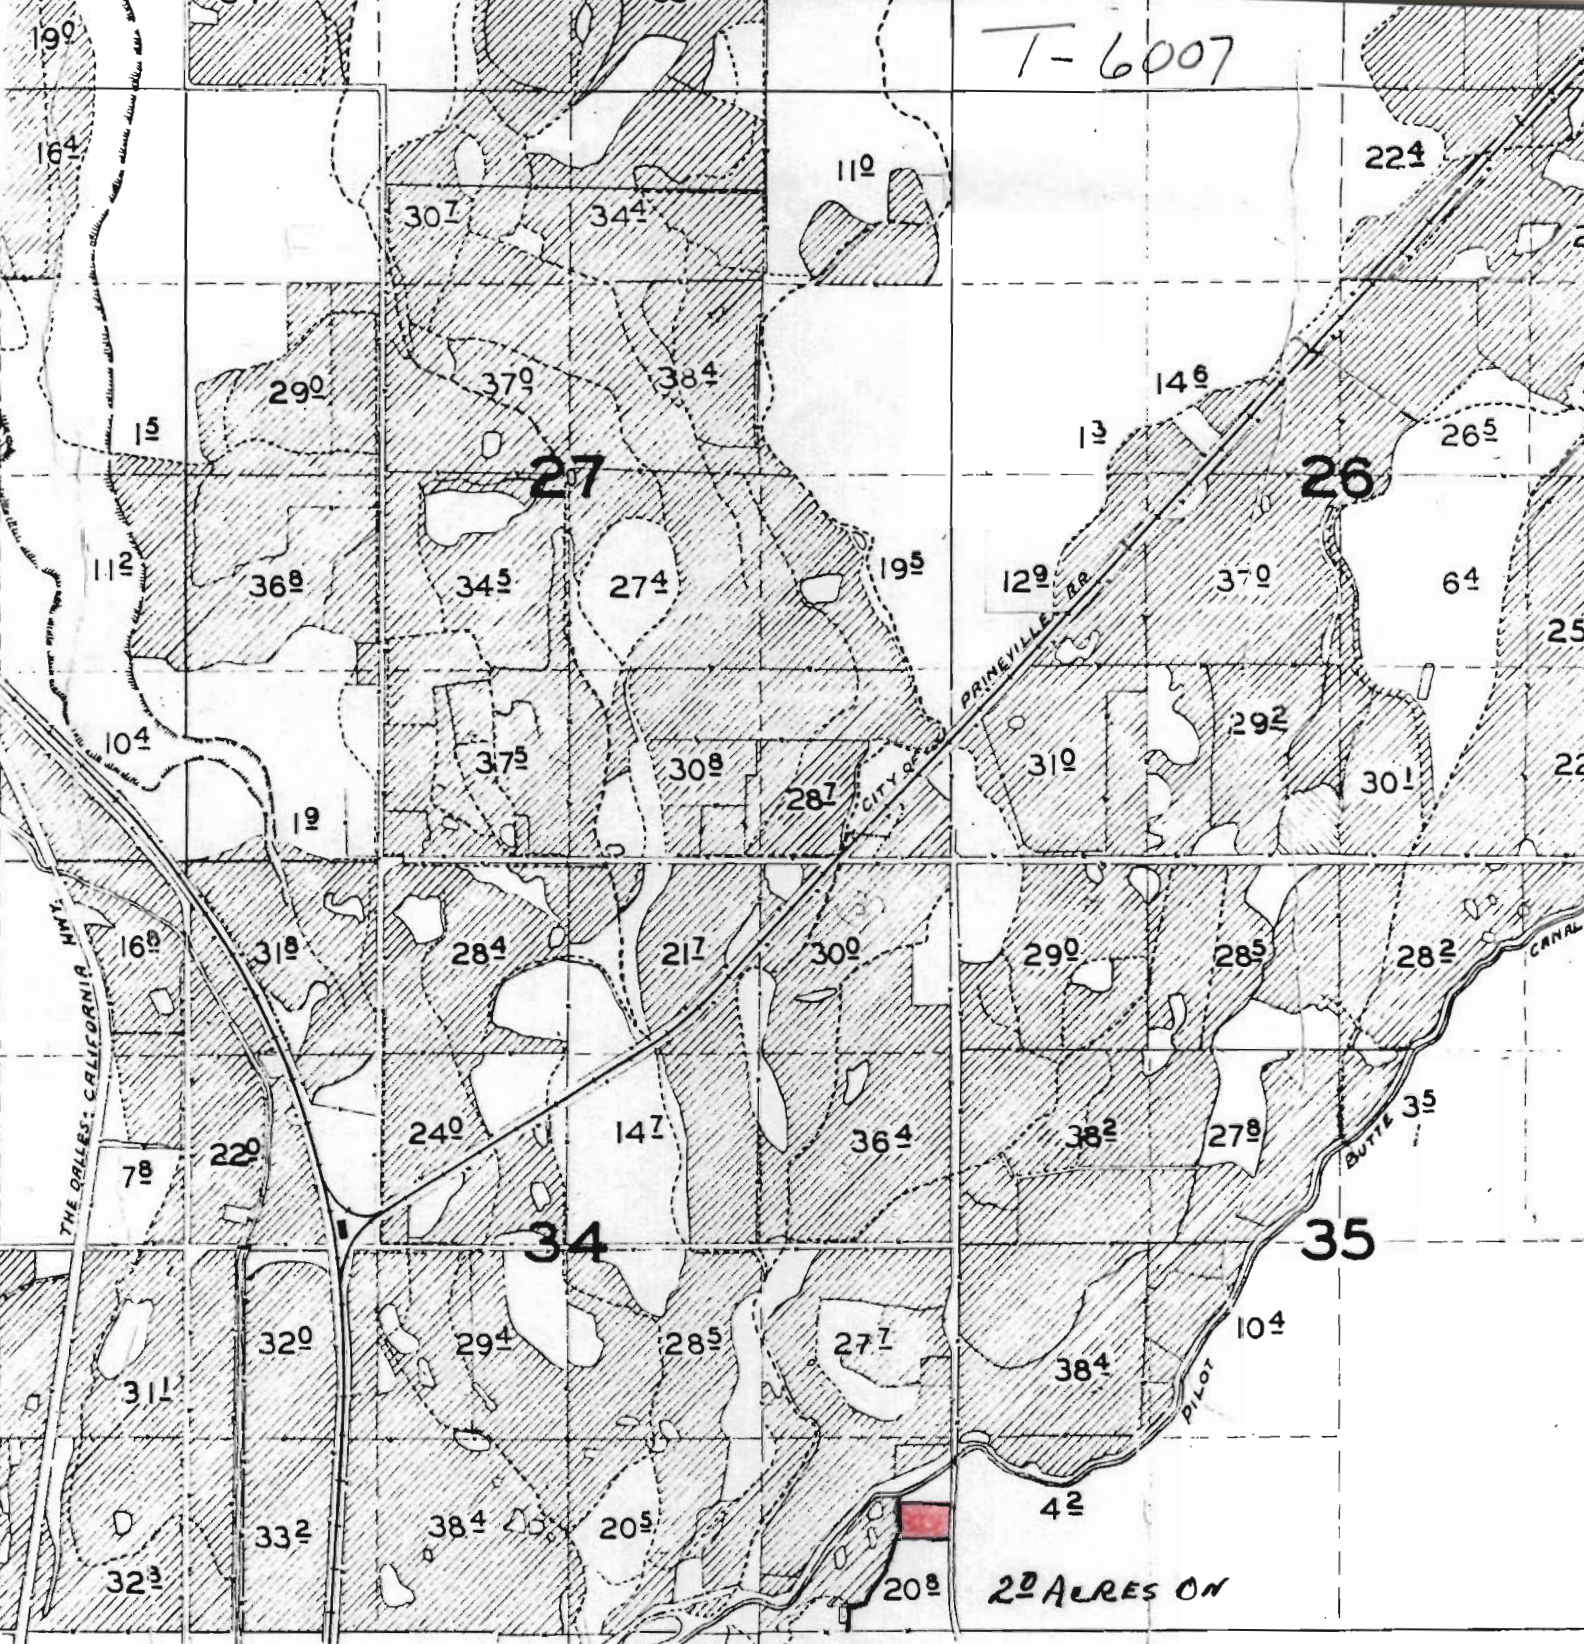

20 ACRES ON

4" = 1 MILE

SURVEYED SEPT 22-30, OCT 1, 2, 5, 6, 7.

RECEIVED

OCT 19 1987

WATER RESOURCES DEPT.
SALEM, OREGON

RECEIVED

OCT 19 1987

WATER RESOURCES DEPT.

SALEM, OREGON

PETER SKENE OGDEN STATE PARK

T-6007

2.0 ACRES ORA
4.1226E

