


T 15 S R 10 E Sec 24

T-6015

RECEIVED
FEB 19 1998
WATER RESOURCES DEPT.
SALEM, OREGON

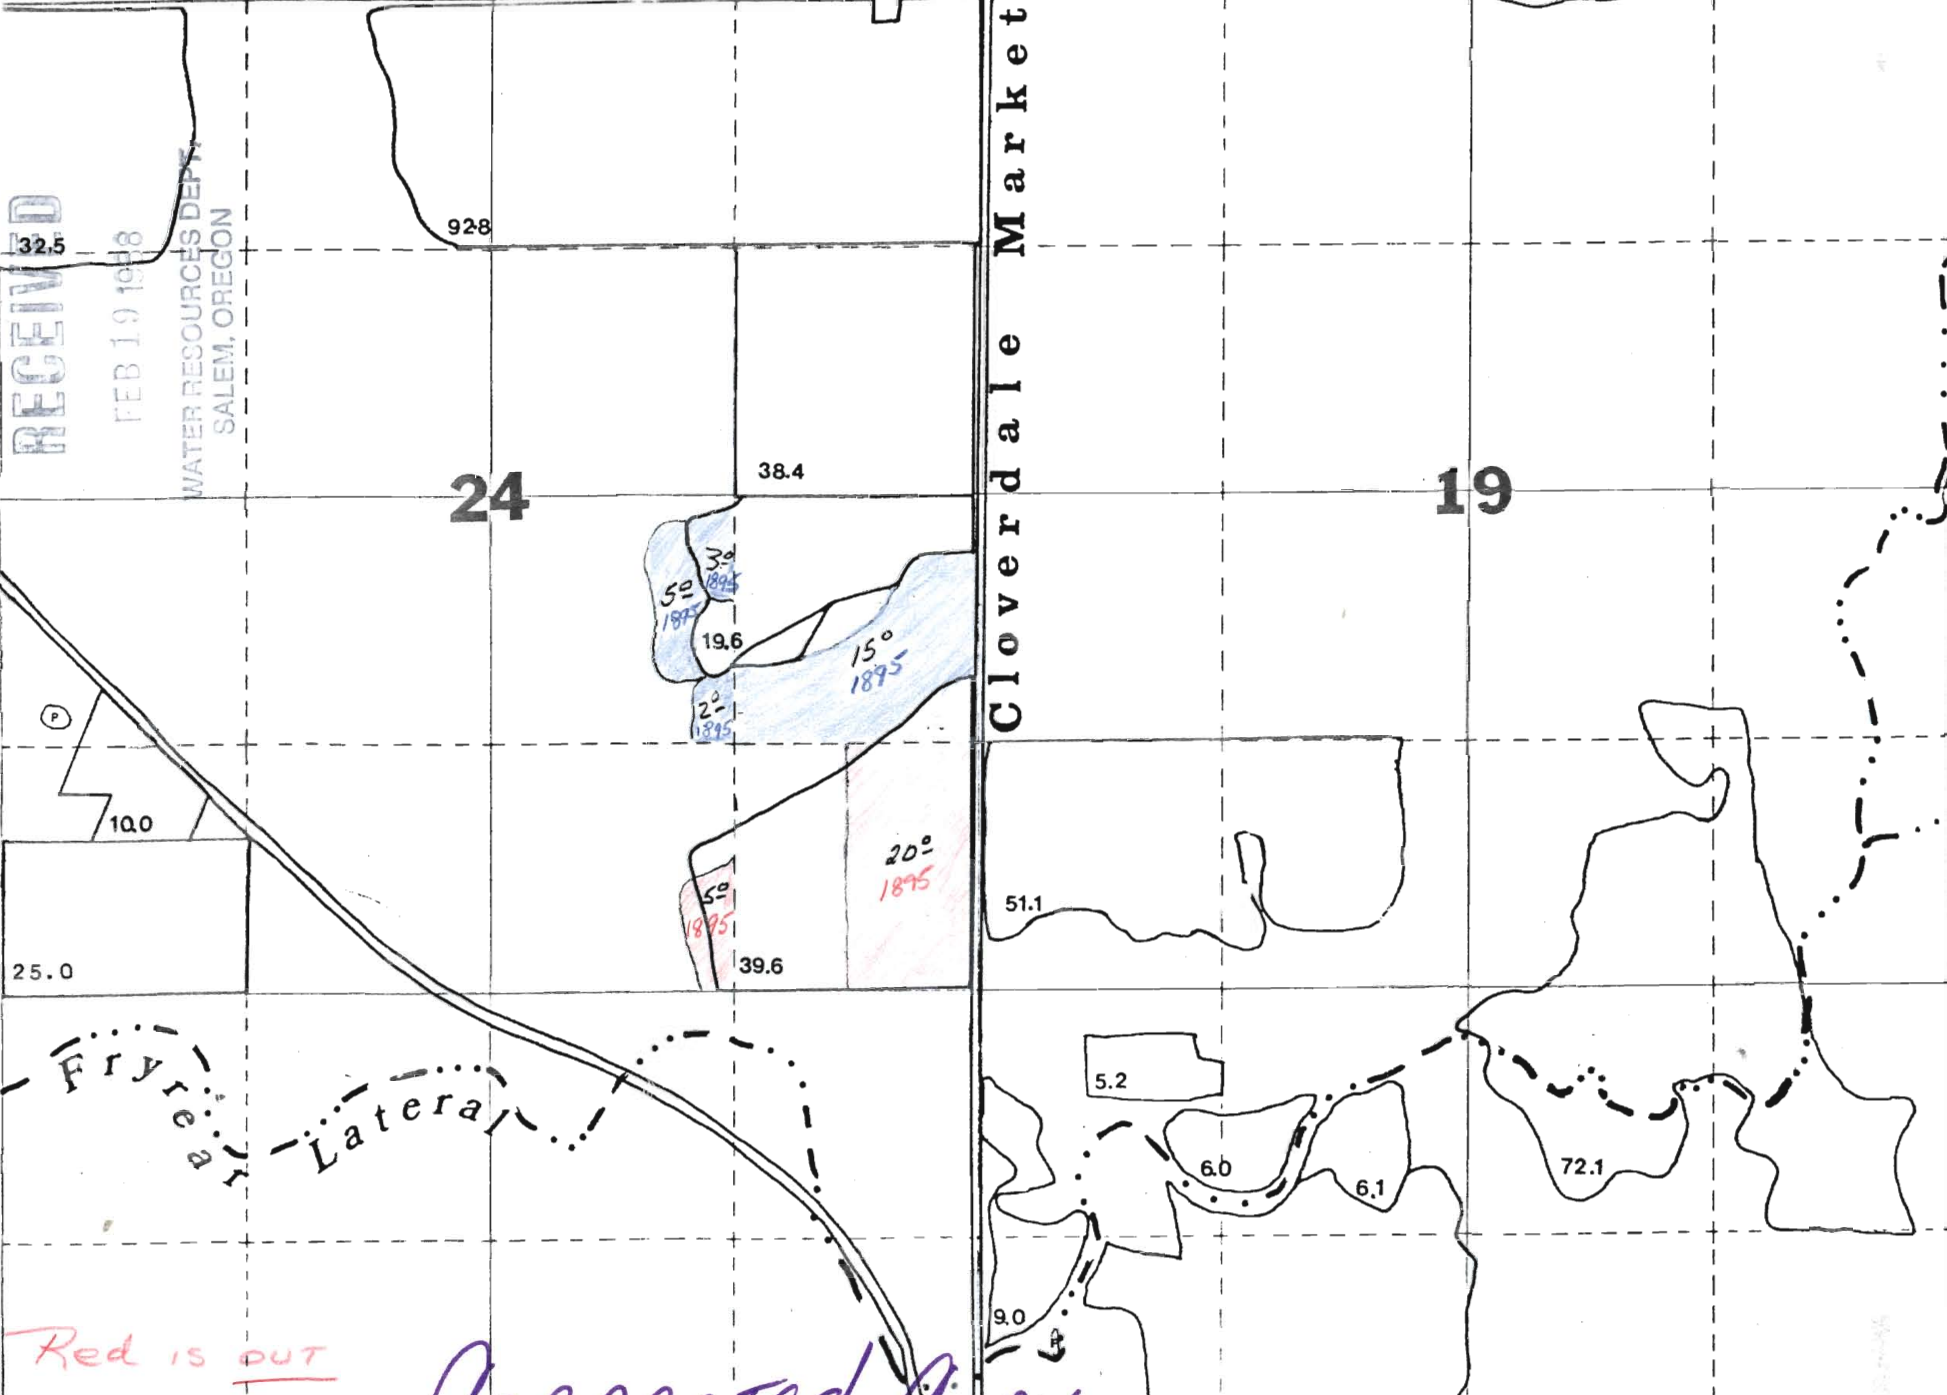

24

19

Cloverdale Market

Red is OUT
Blue is IN

CORRECTED COPY