


T.28S.,R.7 W., W.M.

SCALE 1" = 1320'

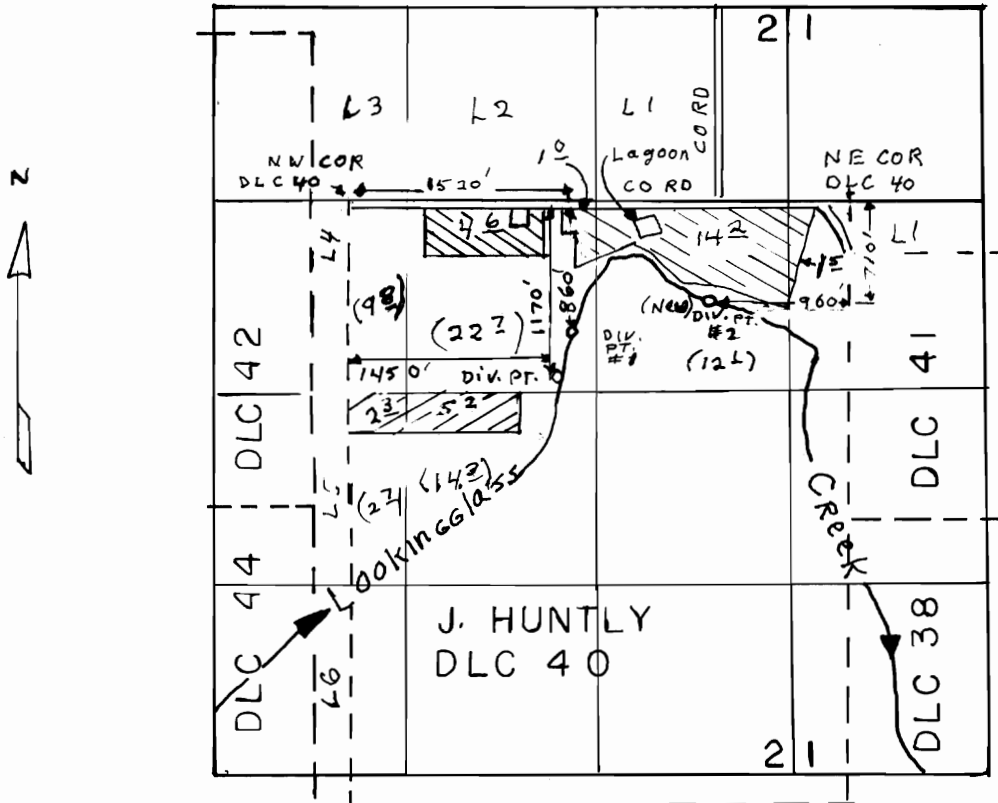

PRIORITY 1950



PRIORITY 1958

THE PURPOSE OF THIS MAP IS TO IDENTIFY THE LOCATION OF THE WATER RIGHT. IT IS NOT INTENDED TO PROVIDE INFORMATION RELATIVE TO THE LOCATION OF PROPERTY OWNERSHIP BOUNDARY LINES.

FINAL PROOF OF SURVEY

UNDER

TRANSFER 6020

IN NAME OF

THE MAXWELL DAIRY

Surveyed Sept. 2 1990 by D. KIRBY

