


T.38S.,R.1W.,W.M.

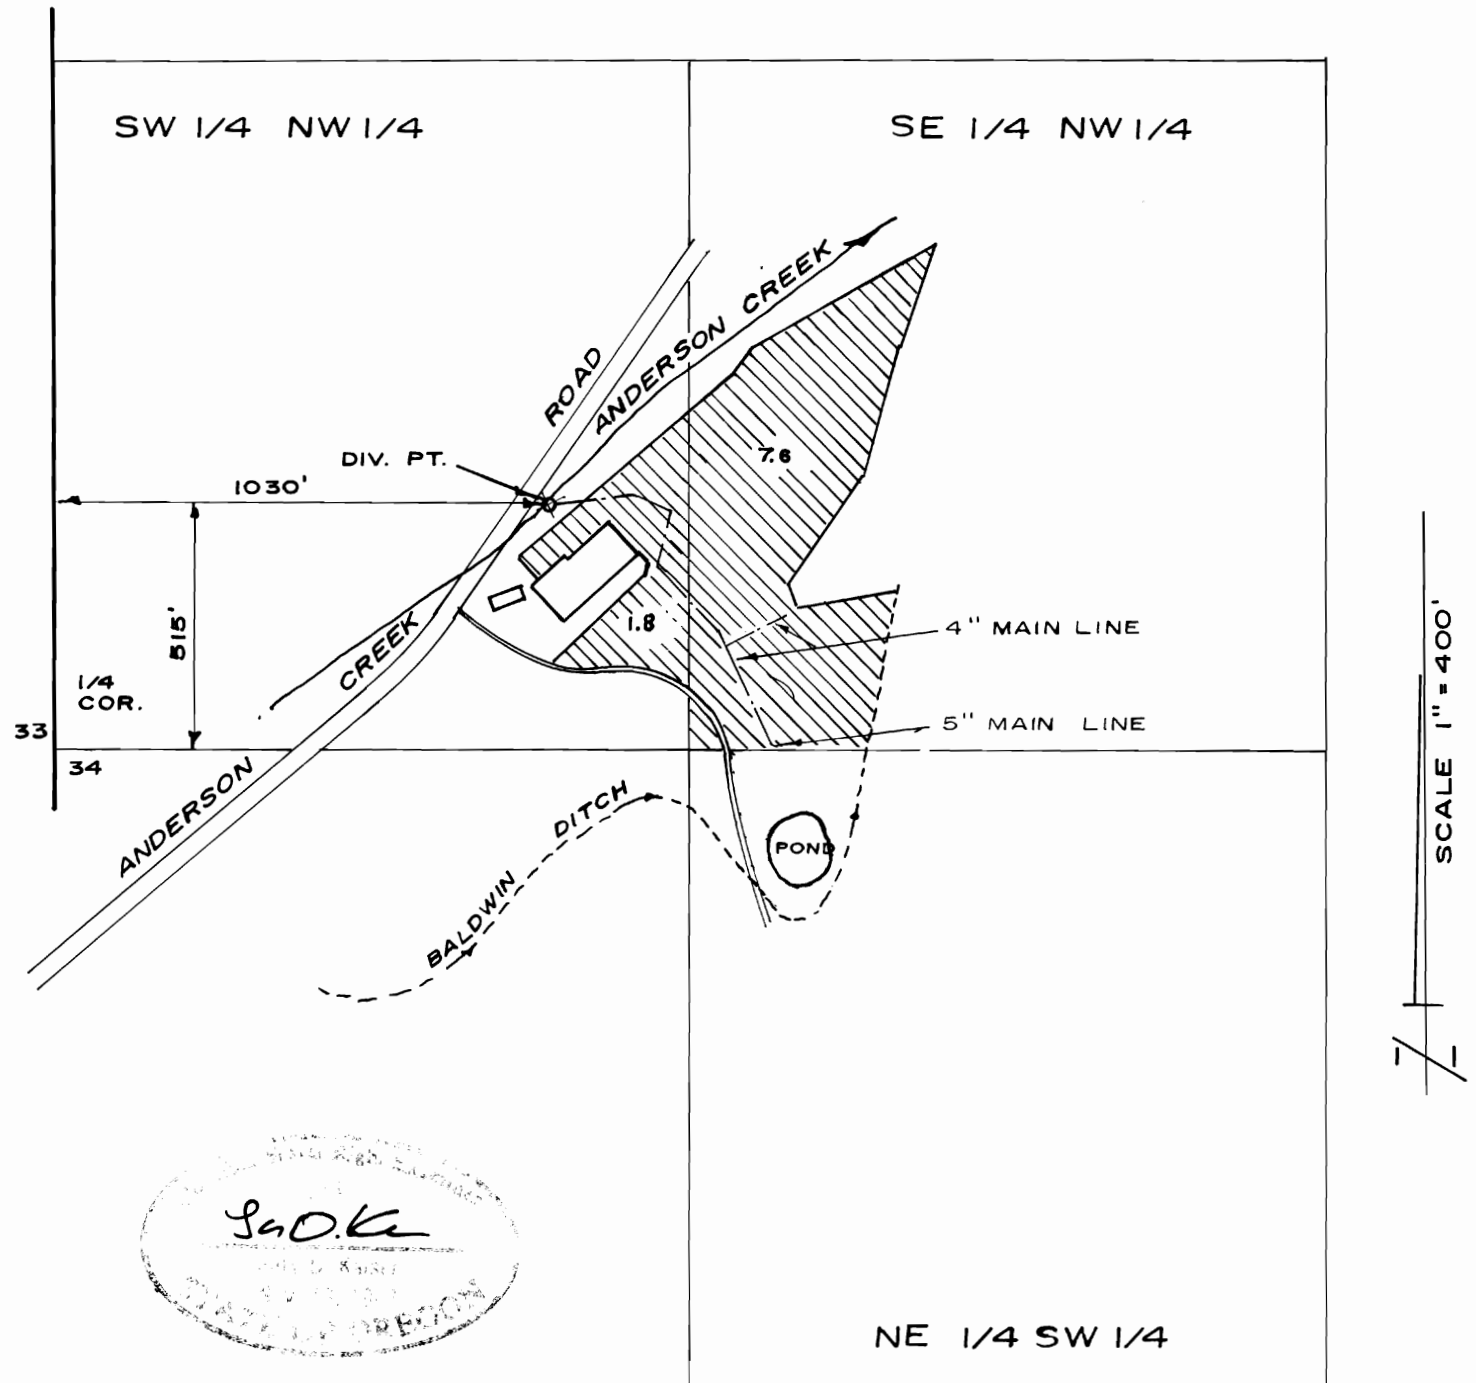

FINAL PROOF MAP

APPLICATION No. T-6024

NOTE: THIS MAP HAS BEEN
PREPARED FOR WATER RIGHT
PURPOSES ONLY, NOT FOR
PROPERTY BOUNDARY LOCATIONS.

IN THE NAME OF

WARREN J. FERGUSON

MAP PREPARED SEPTEMBER 23, 1991 BY GARY D. KAISER

REVISED APRIL 22, 1992 GDK