


**SECTION 7, TWP.2 N. RANGE 12 E. W.M.
WASCO COUNTY, OREGON**

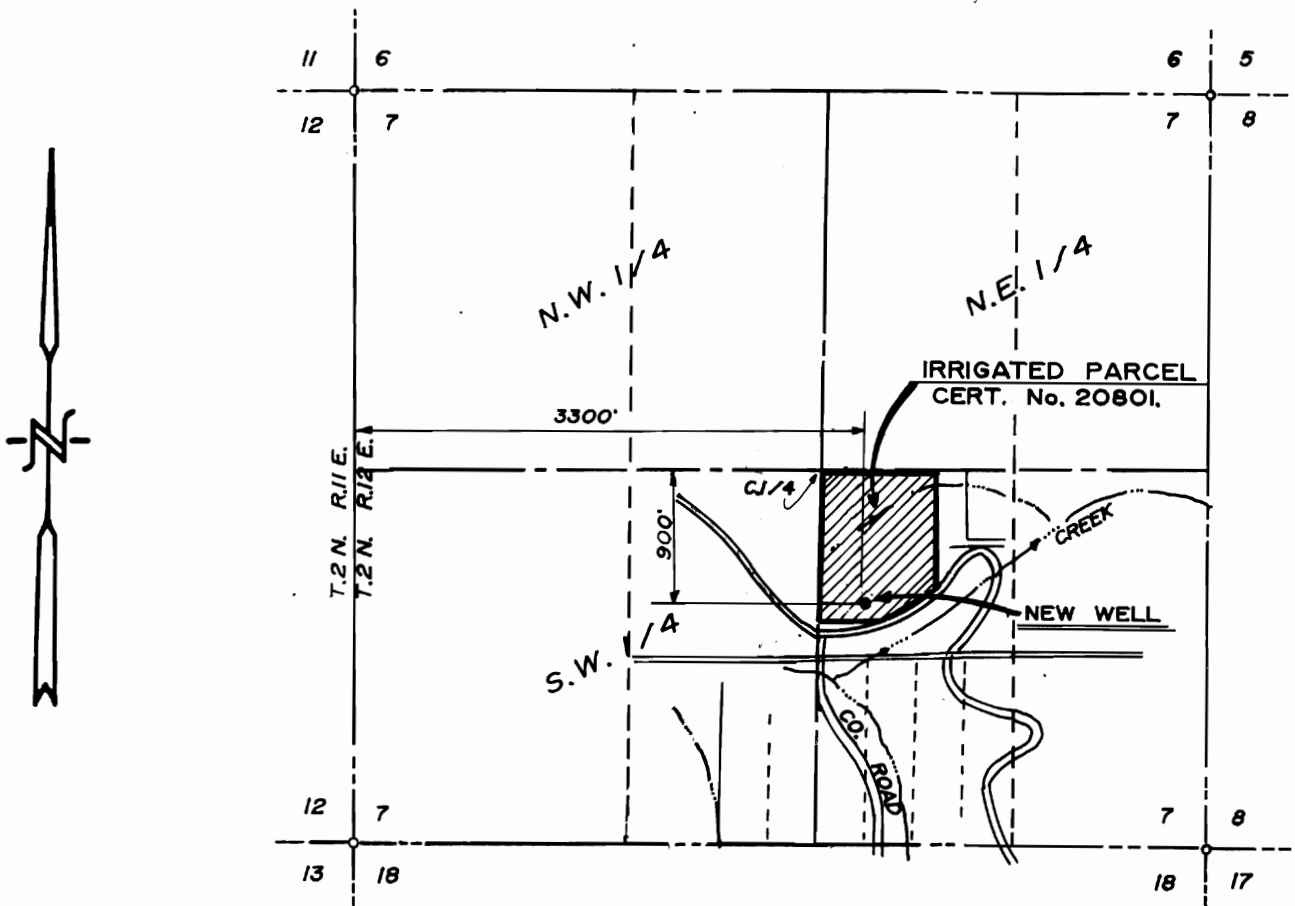

FINAL PROOF SURVEY

SCALE: 4" = 1 MILE

TRANSFER No. T-6031

IN THE NAME OF:
DIEGO LEON

NOVEMBER 6, 1989.

BY:
TENNESON ENGINEERING CORP.
409 LINCOLN STREET,
THE DALLES, OREGON, 97058
PH. (503) 296-9177

NOTE:

"THIS MAP IDENTIFIES THE LOCATION OF THE WATER RIGHT ONLY AND IS NOT INTENDED TO PROVIDE DIMENSIONS OR LOCATE PROPERTY OWNERSHIP LINES."

