


T.28S. R.6W. W.M.

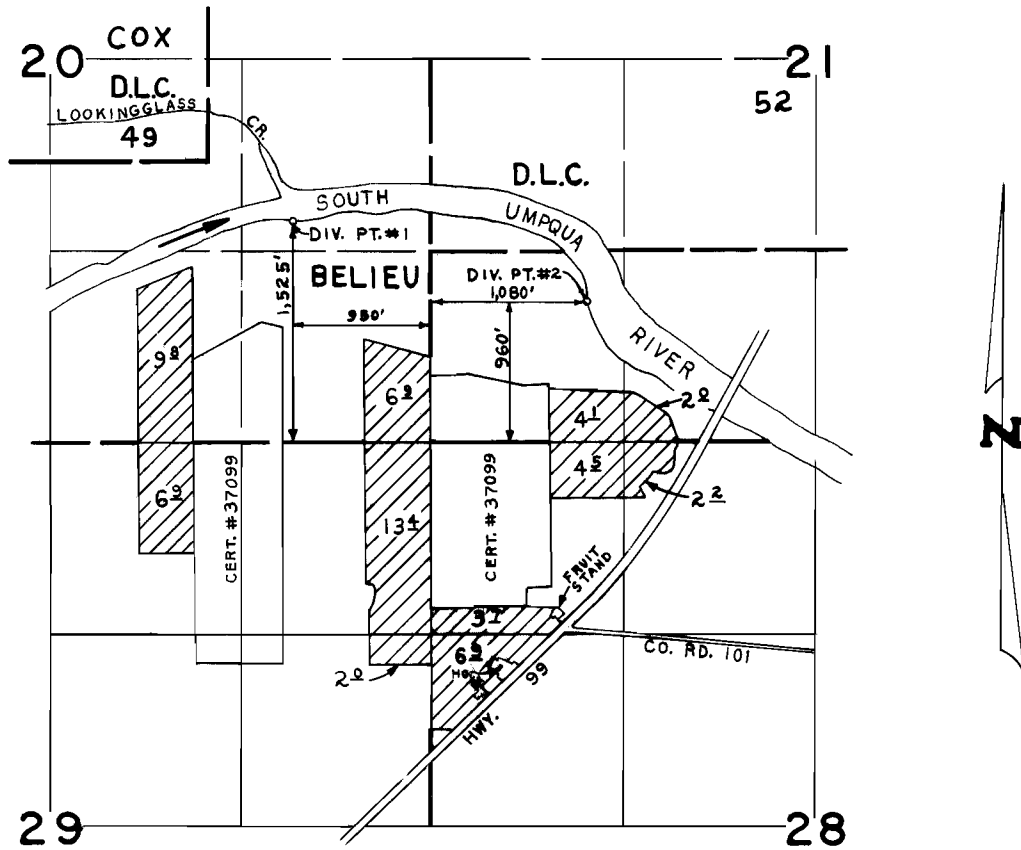

SCALE: 4" = 1 mile

FINAL PROOF SURVEY UNDER

Application No. ~~63428~~ Permit No. ~~46774~~.....
IN NAME OF

DAVID K. BURKS

Surveyed ...DEC. 8, 1983, by L. CASHION....