RECEIVED
OCT 19 1987
WATER RESOURCES DEPT
RECEIVED
NOV 23 1987
WATER RESOURCES DEPT.
SALEM, OREGON

EPID
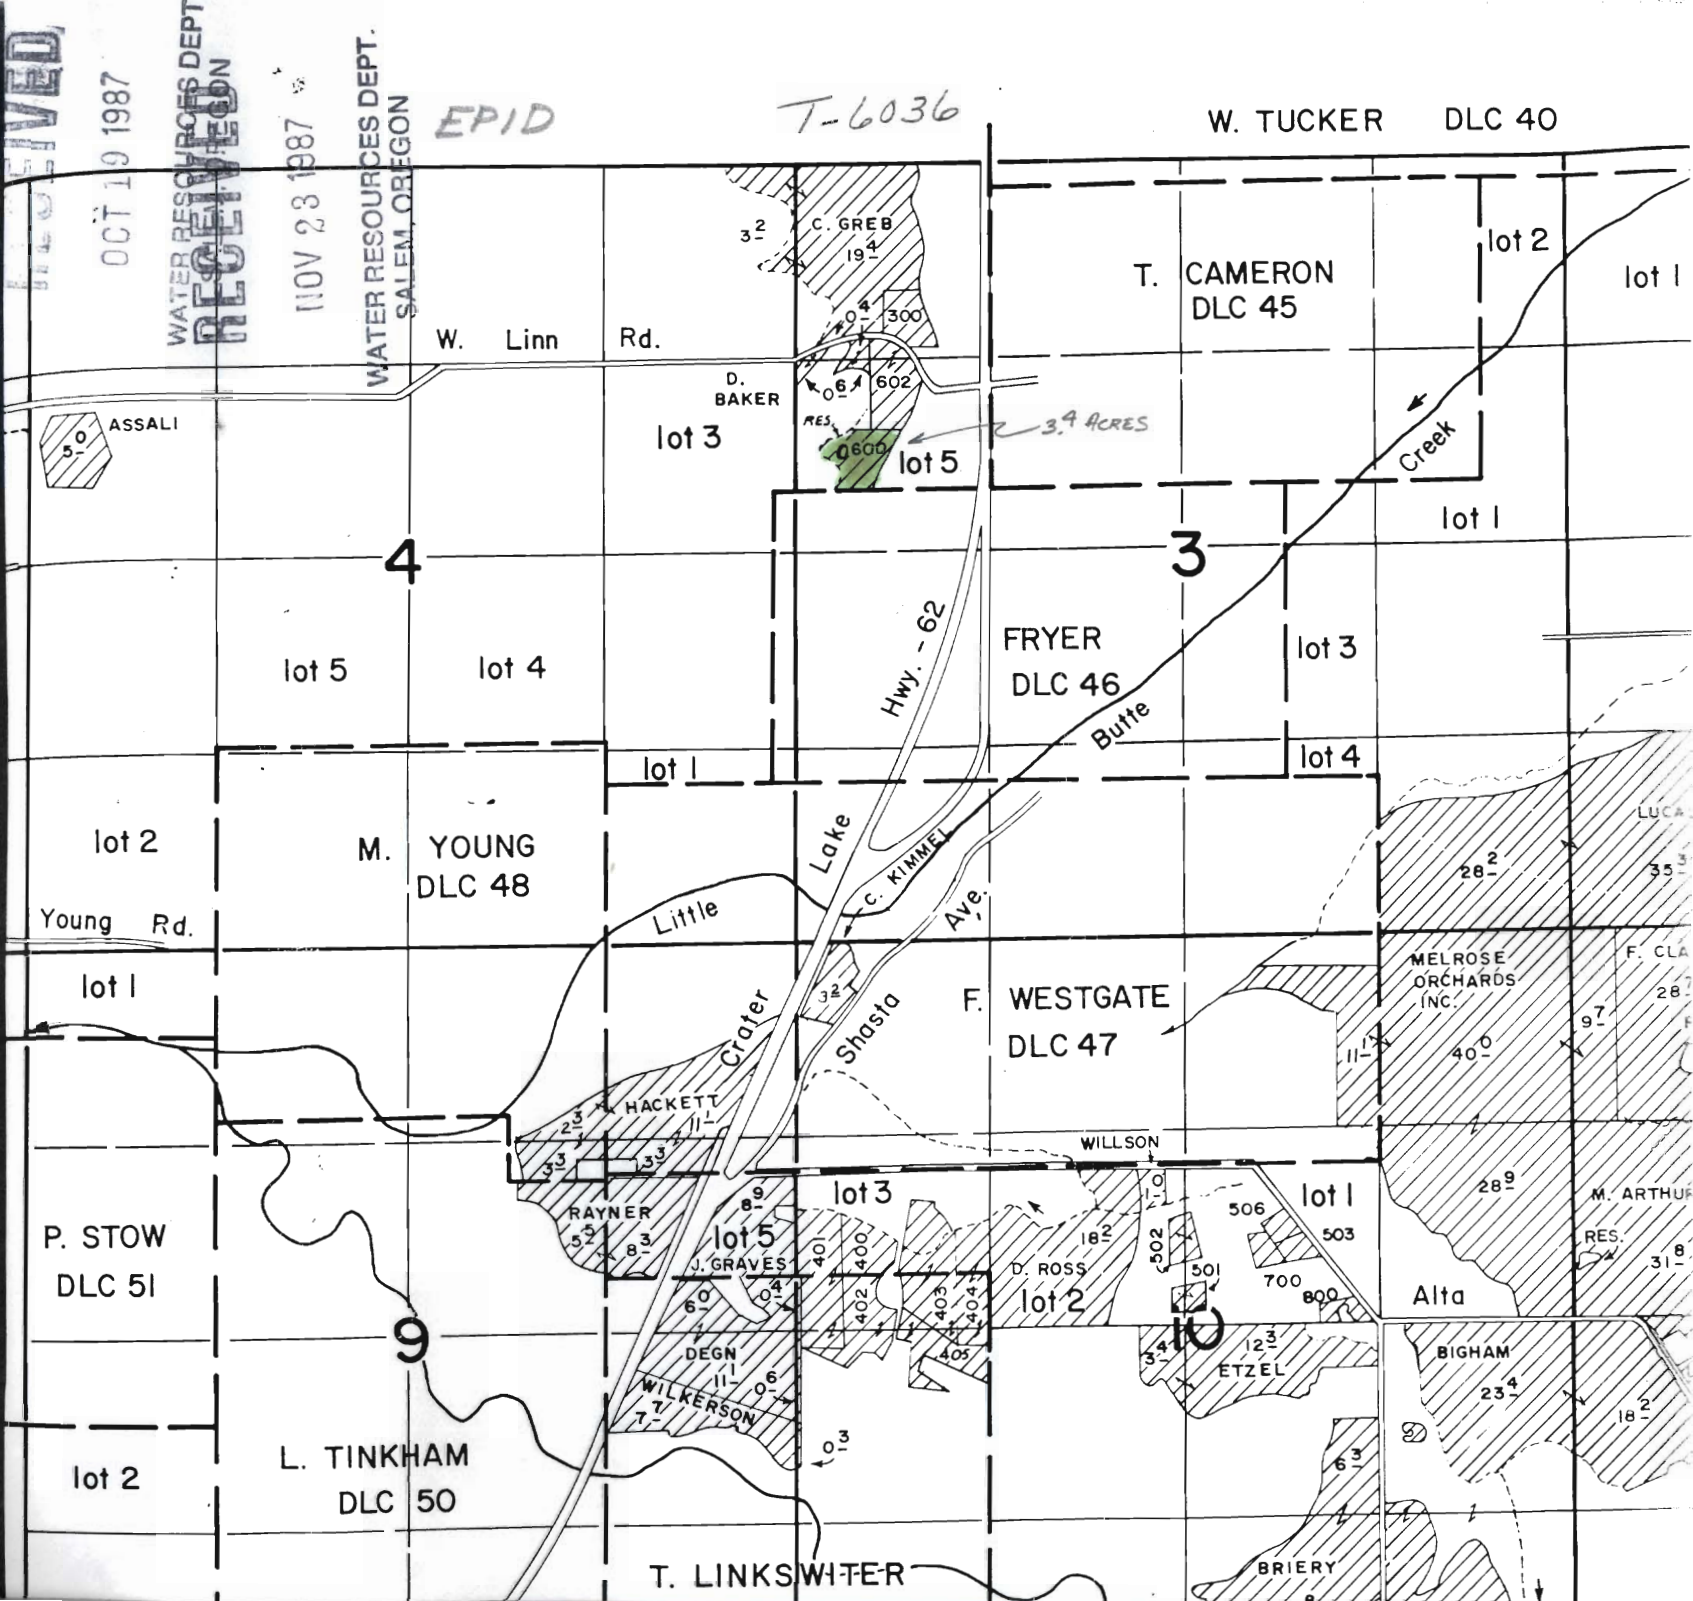
T-6036