


T.15S., R.13E., W.M.

1.84 AC. PER
T-6045

EXISTING
RIGHTS IN THE
AREA, NOT A
PART OF THIS
FINAL PROOF

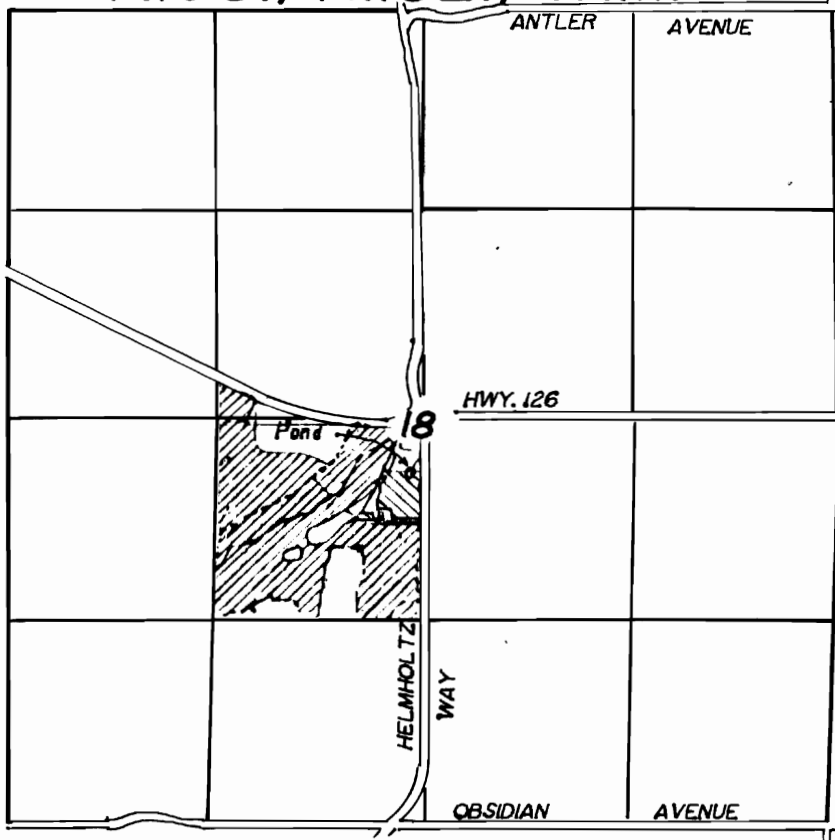

SCALE: 1" = 1320'

FILED
 AUG - 2 1989
 WATER RESOURCES DEPT.
 S - 1 - TEL. 346-1111

**FINAL PROOF SURVEY
UNDER**

TRANSFER NO. 6045

Application No. _____ Permit No. _____

IN NAME OF

RICHARD J. MORTON / COID

I, Robert R. Povey, Oregon Certified Water Right Examiner #106, hereby certify the above application map was prepared under my direct supervision.

The preparation of this map is for the purpose of identifying the location of the water right only and has no intent to provide dimensions or locations of property ownership lines.

