


FINAL PROOF SURVEY MAP IN THE NAME OF JOSEPH L. SONKA

PERMIT 12200

TRANSFER T-6059

SECTION 6, TOWNSHIP 30 SOUTH, RANGE 5 WEST, W.M.

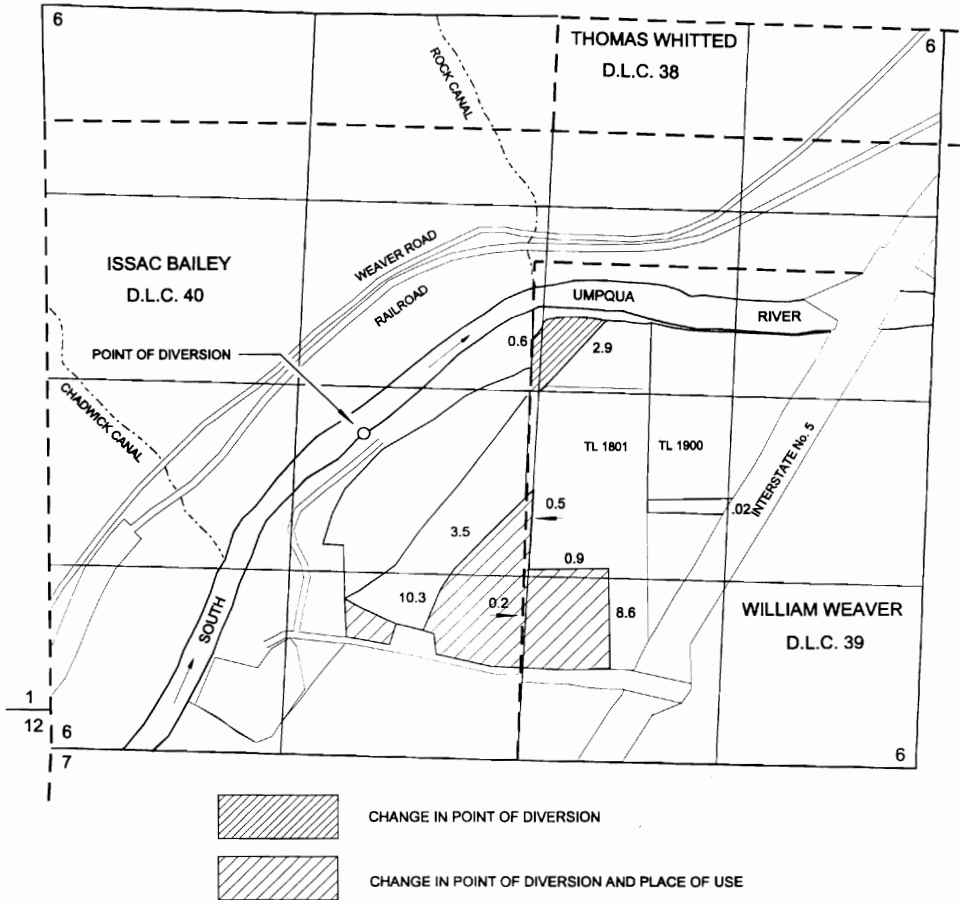

THE POINT OF DIVERSION IS LOCATED 2200 FEET NORTH AND 2140 FEET EAST FROM THE SOUTHWEST CORNER OF SECTION 6; BEING WITHIN THE NE $\frac{1}{4}$ SW $\frac{1}{4}$, AS PROJECTED WITHIN ISSAC BAILEY D.L.C. 40, OF SECTION 6, TOWNSHIP 30 SOUTH, RANGE 5 WEST, W.M.; DOUGLAS COUNTY.

