



WELL LOCATION FOR FINAL PROOF SURVEY
OF TRANSFER NO. 6070.

STATE HIGHWAY 140

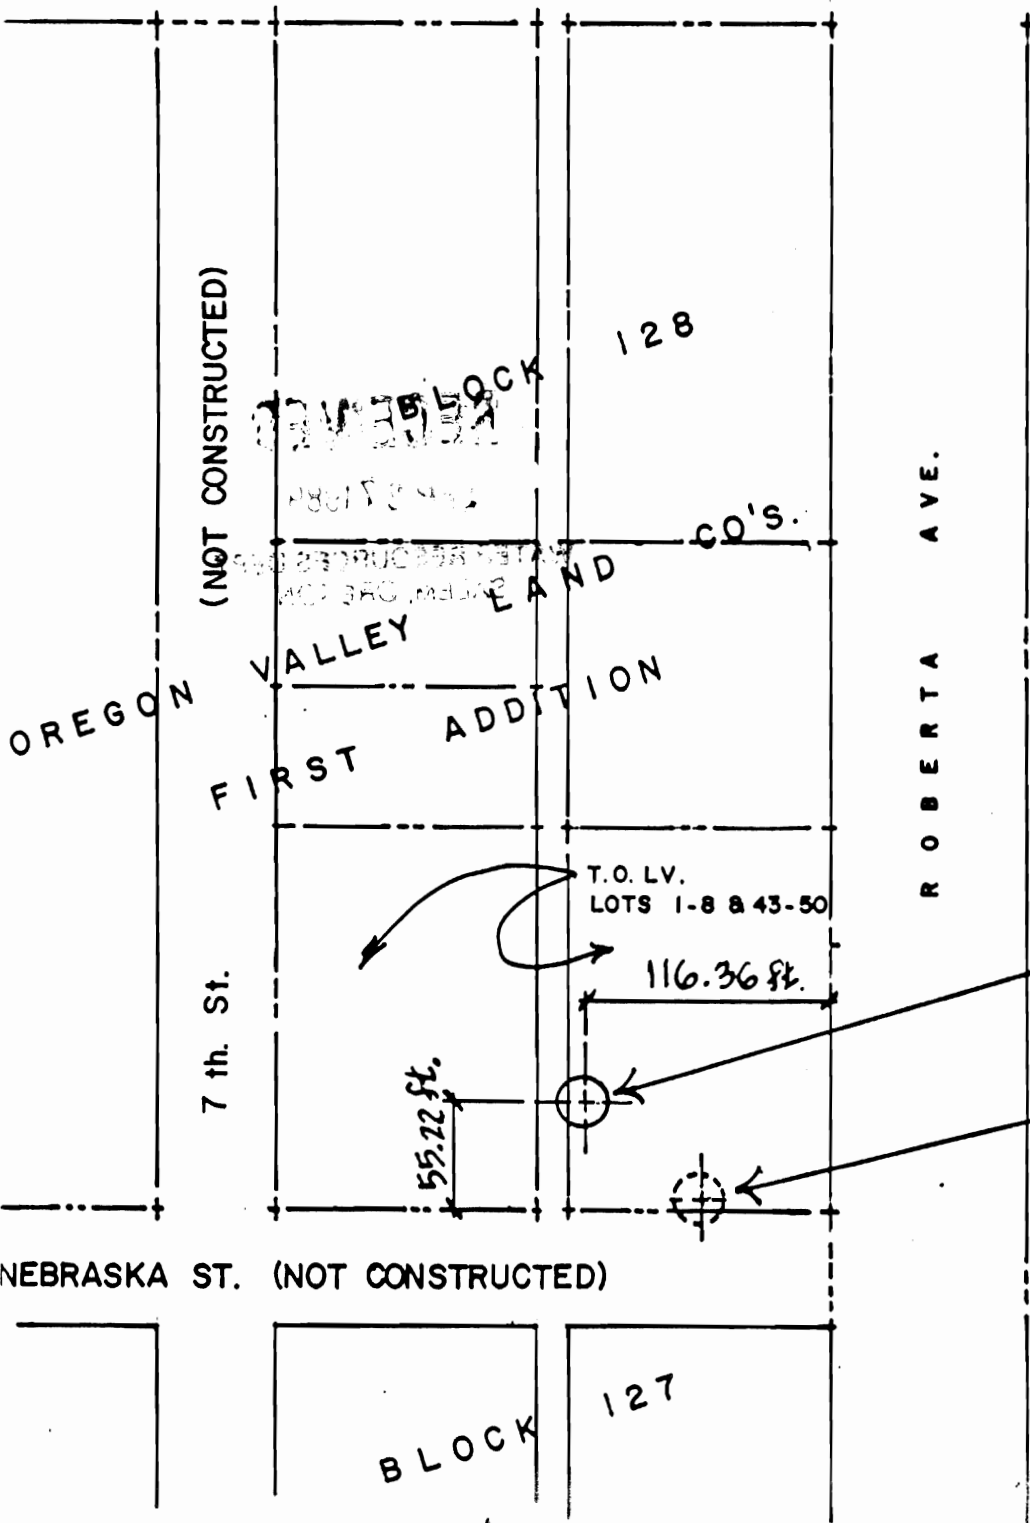

THIS MAP IS FOR THE PURPOSE
OF IDENTIFYING THE POINT OF
APPROPRIATION ONLY, WITH NO
INTENT TO PROVIDE DIMENSIONS
OR LOCATION OF PROPERTY
OWNERSHIP LINES.

EXISTING CERTIFICATE NO. 26520
TRANSFER NO. 6070

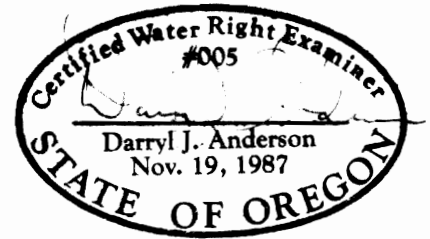

WELL NO. 8
REPLACEMENT WELL
400 FT. DEEP

WELL NO. 3 ABANDONED
283 FT. DEEP
TO BE USED AS MONITORING
WELL

OWNER: TOWN OF LAKEVIEW
525 NORTH 1st STREET
LAKEVIEW, OREGON

DETAIL PLAN - WELL LOCATIONS

1" = 100'

ANDERSON ENGINEERING & SURVEY

BOX 20 LAKEVIEW, OR, 97030
(503) 867-6607