


T.4S., R.1W., W.M.

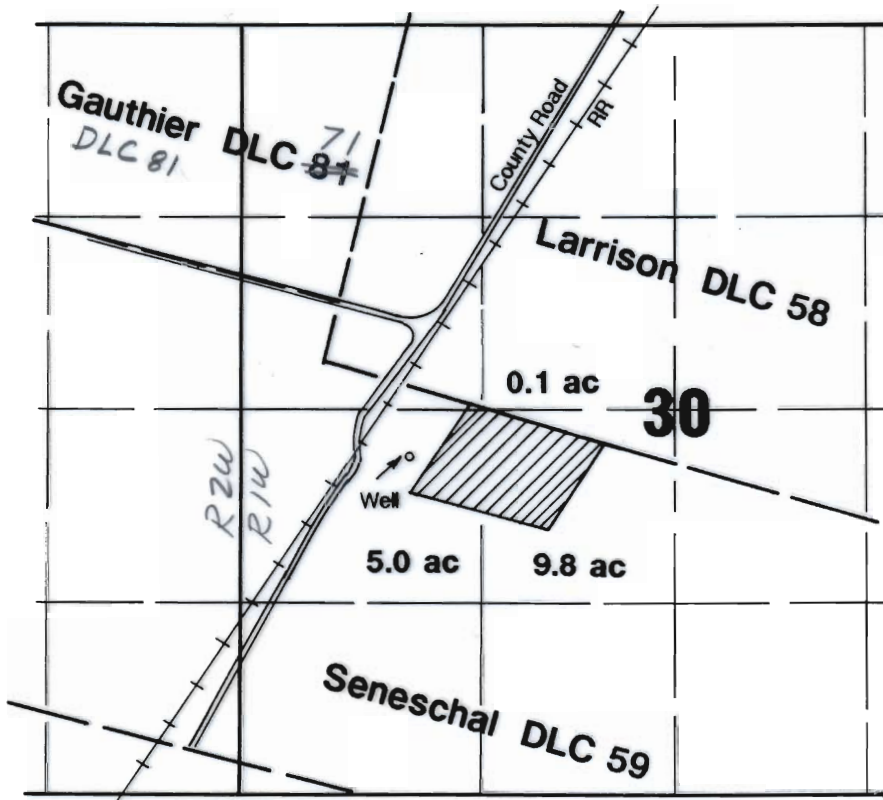

Well located 1040'S & 470'E from SE cor. Gauthier DLC 71.

Scale: 1"= 1320'



NOTE: Map is for the purpose of identifying location of water right and has no intent to dimension or locate property ownership lines.

Final Proof Survey

Transfer #: 6081

UNDER

Agustin & Maria C. Palacios

Surveyed October 31, 1989 by JMS

