

Additional Well located 1193'S & 935'W from NE corner Section 14.  
 Authorized Well located 1320'S & 1300'E from SW corner Webb DLC 56.


## Final Proof Survey

Transfer #: 6086

UNDER

## Clayton McCullough

Surveyed 11-29-89 by JMS

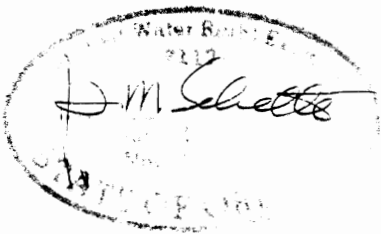

NOTE: Map is for the purpose of identifying location of water right and has no intent to dimension or locate property ownership lines.