


T. 9 S., R. 40 E. W.M.

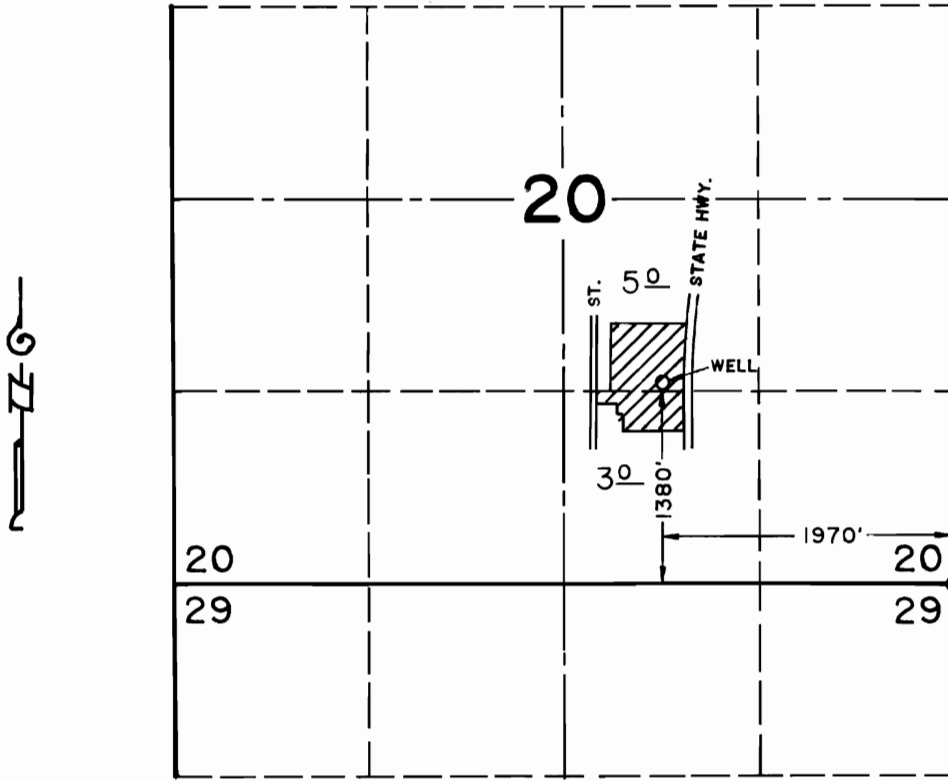

SCALE 1" = 1320'

THE PURPOSE OF THIS MAP IS FOR IDENTIFYING THE LOCATION OF THE WATER RIGHT ONLY AND IS NOT INTENDED TO PROVIDE LEGAL DIMENSIONS OF PROPERTY OWNERSHIP LINES.

FINAL PROOF SURVEY UNDER

Transfer No. 6087

IN NAME OF

CONDON J. & DEBORAH J. VAN HOOMISSEN

Surveyed Aug. 7, 1992

