# T4N, R27E, W.M.

MORROW COUNTY, OREGON

## FINAL PROOF SURVEY

T-6097, T-6098, T-6099, T-6100, T-6101 and T-6102

IN THE NAME OF

JEDEDIAH AYLETT

Rt. 1, Box 1818

Hermiston, Ore. 97838

567-5938

T-6097

T-6098

T-6099

T-6100

T-6101

T-6102

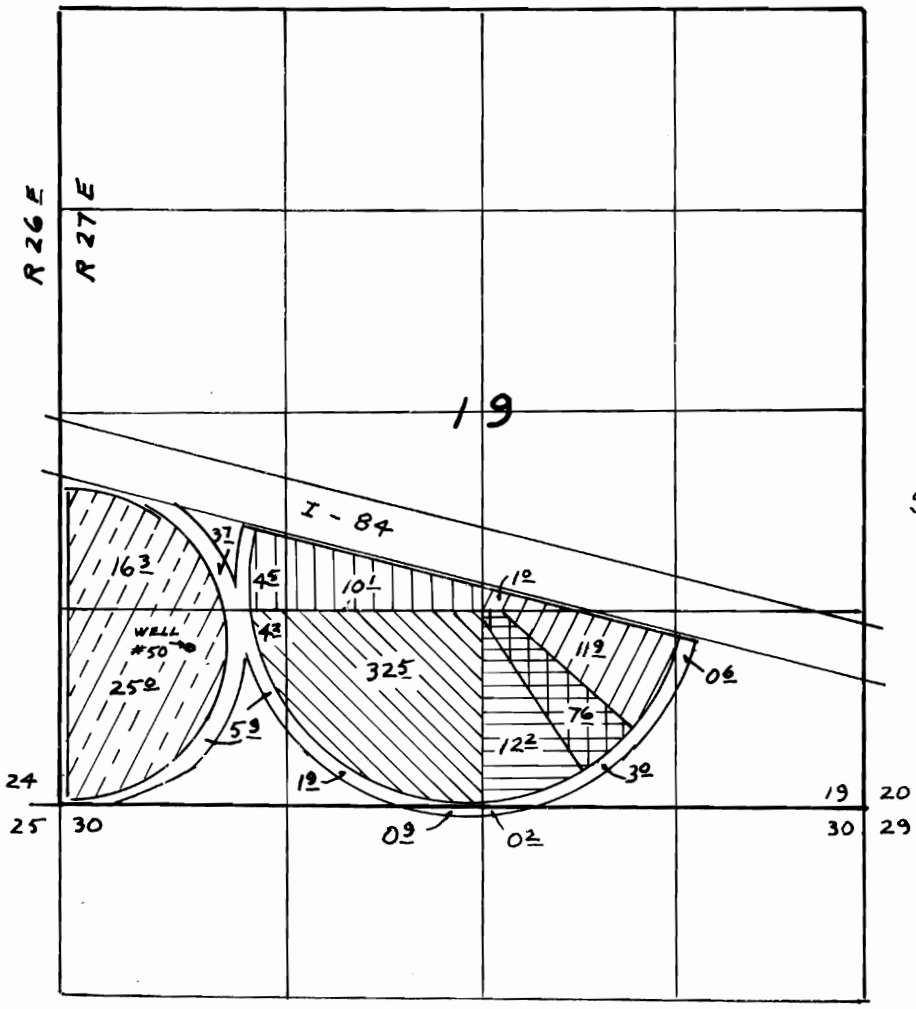


Scale: 1" = 1320'

Well # 50 lies 1077 feet N. and 910 feet E. of SW corner of Section 19.

Certified Water Right Examiner
#043 WRE
C. Dennis Edwards
Nov. 19, 1987
STATE OF OREGON

Edwards Surveying P.O. Box 763
567-3336 Hermiston, OR. 97838
10/1/91 Job # W8803009-A

This map is for identifying the location of water rights only and is not intended to show property lines or dimensions.