


T.36 S., R.6 W., W.M.
N.W. 1/4 SECTION 21

SCALE: 1" = 400'

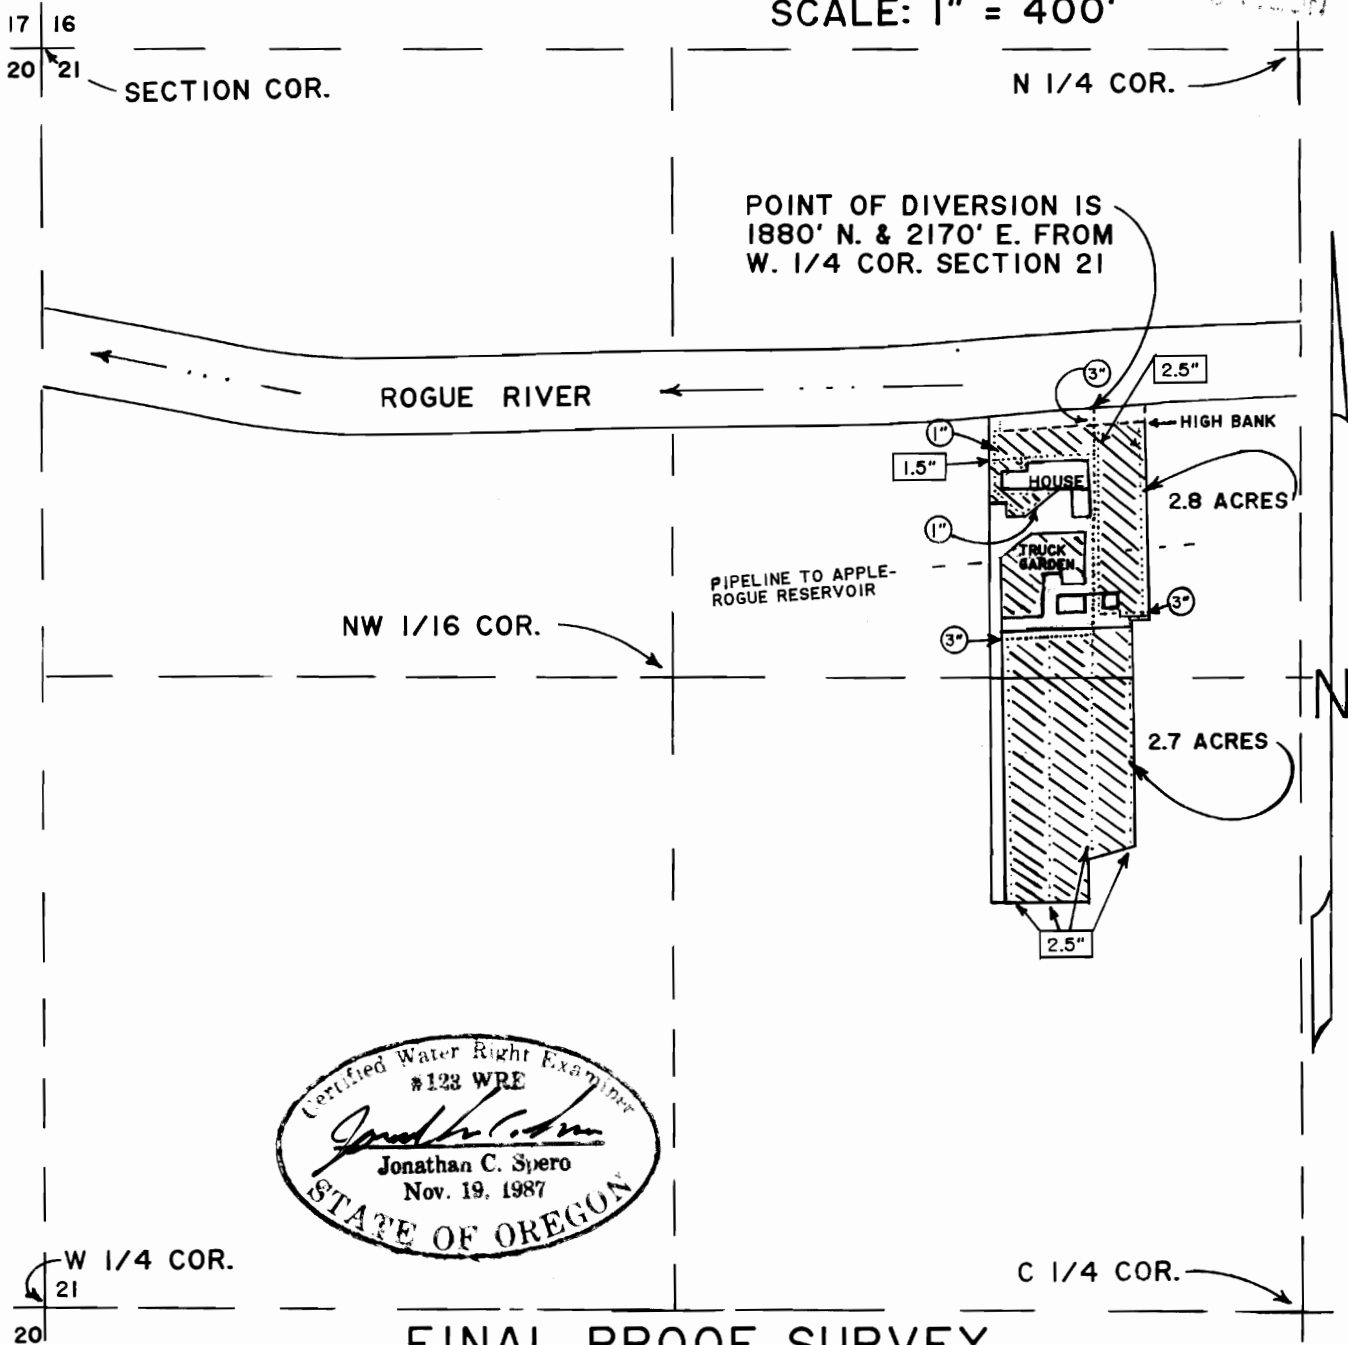

FINAL PROOF SURVEY
UNDER

APPLICATION NO. T-6104 & T-6292 PERMIT NO. 1155 CERTIFICATE NO. 57598

IN NAME OF
BURTON W. BLACKWELL

SURVEYED FEBRUARY 12, 1990 BY *Jonathan C. Spero*