


T.16 S., R.12 E., W.M.

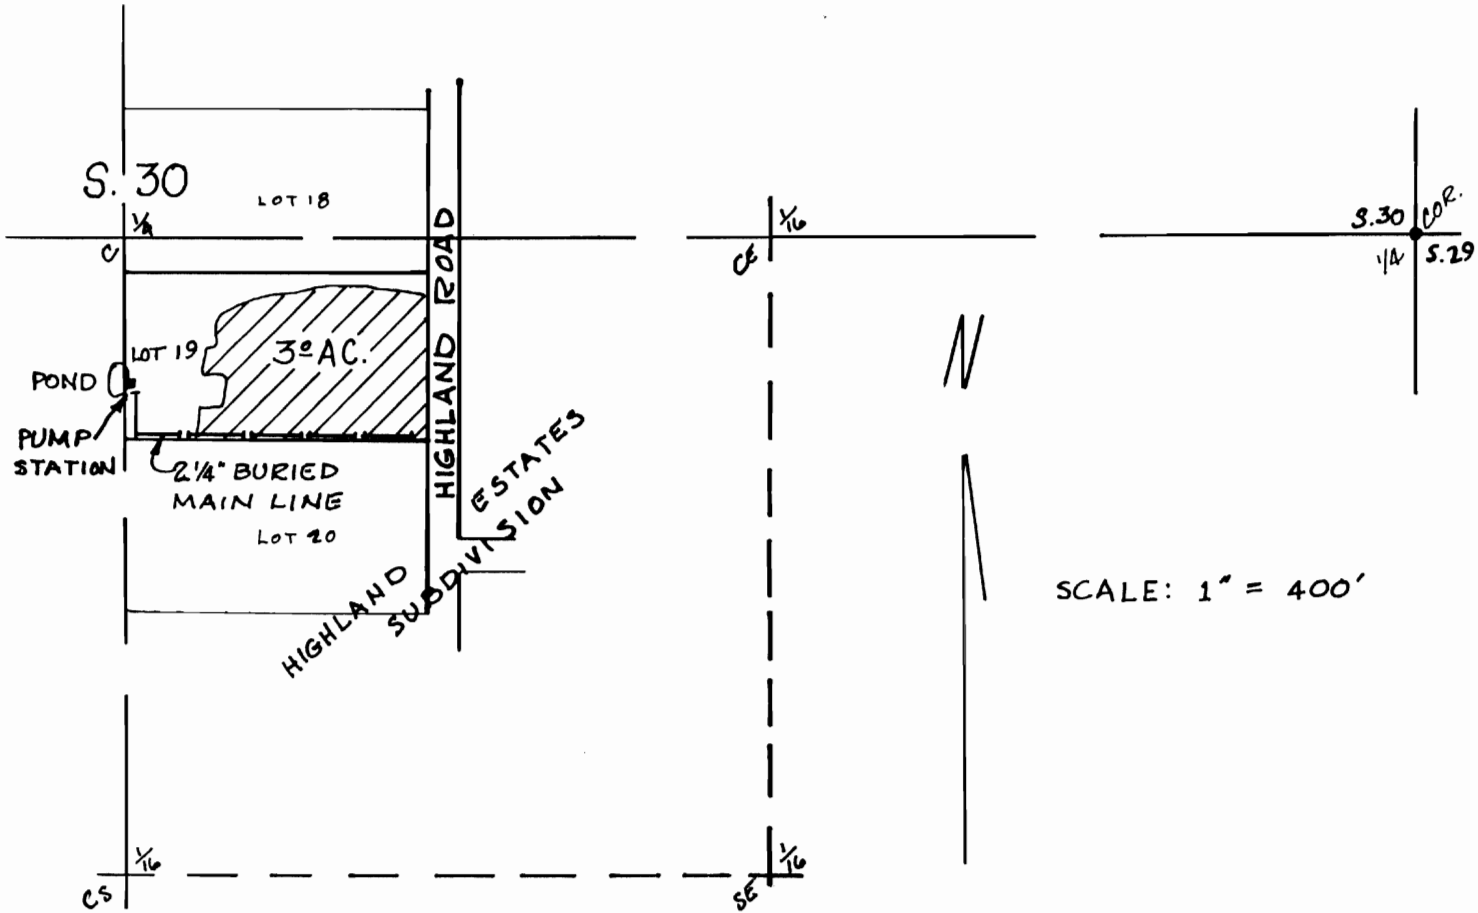

FINAL PROOF SURVEY
UNDER

ON-LAND  TRANSFER NO. 6105

IN NAME OF

PATRICK B. GREGG

SURVEYED 12 JUNE 1989 BY R. E. OMAN

