


# T.18 S.R.47E. W.M.

SCALE 1" = 1320'

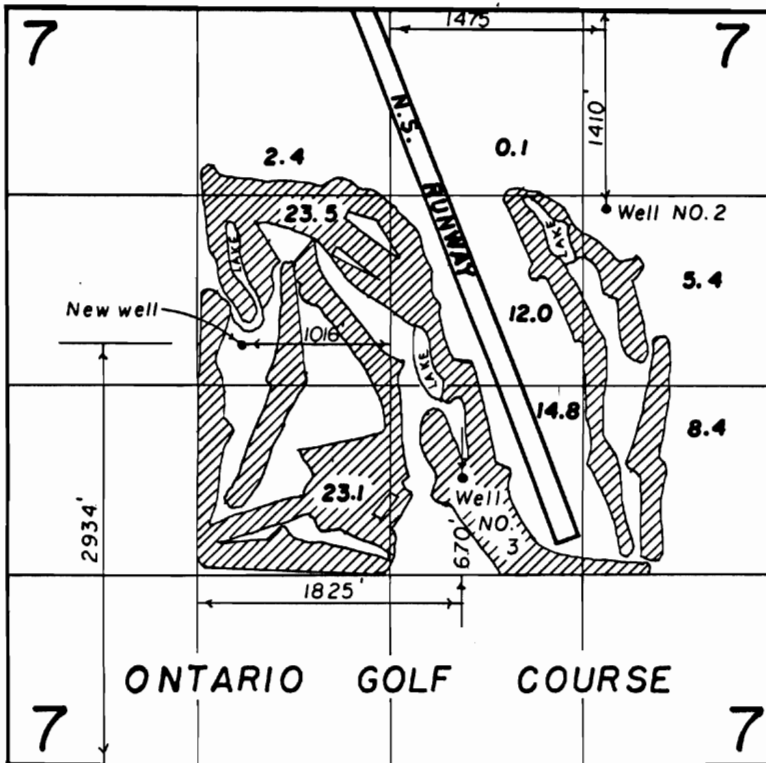

## FINAL PROOF SURVEY

UNDER

TRANSFER APPLICATION NO. T-8106

IN NAME OF

THE CITY OF ONTARIO

SURVEYED MAY 30 1989 by R.A. BJORKLUND



THIS MAP IS FOR THE PURPOSE OF IDENTIFYING THE LOCATION OF THE WATER RIGHT ONLY AND IS NOT INTENDED TO PROVIDE LEGAL DIMENSIONS OR LOCATIONS OF PROPERTY OWNERSHIP LINES.